

Appendix D

Monee Reservoir


<u>Topic</u>	<u>Page Number</u>
Appendix D-1 – Inflow Diversion Calculations for Monee Reservoir.....	107-110
Appendix D-2 – Morning Glory Outlet Pictures at Monee Reservoir	111-112
Appendix D-3 – Outlet Rating Curve for Monee Reservoir.....	113-114
Appendix D-4 – As Built / Record Drawings for Monee Reservoir.....	115-137

MONEE RESERVOIR INFLOW DIVERSION CALCULATIONS

PREPARED BY: AJM
CHECKED BY: BJW

DATE: 1/26/2011
DATE: 1/27/2011

Increment (ft) = 0.10

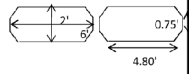
Elevation (ft)	Box Culverts (west)		
	Inlet Orifice Control	Inlet Weir Control	Overflow Weir Control
	$Q_{inlet} = CA(2gH)^{1/2}$ (from p. 458, Eq(1) from Design of Small Dams)	$Q_{overflow} = CLH^{3/2}$ (from p. 467 Design of Small Dams)	$Q_{overflow} = CLH^{3/2}$ (from p. 467 Design of Small Dams)
	control elevation (ft)	control elevation (ft)	control elevation (ft)
	C= (usually 0.6)	C=	C=
	A (ft ²) Rectangular =	L (ft) =	L (749.9 to 752) (ft) =
	$A_{square} (ft^2) =$ 9.6 $A_{trapezoid} =$ 0.5(b1+b2)*h $A_{trapezoid} (ft^2) =$ 1.375 Total Area (ft ²) = 10.975 	This is for the low flow going through the culverts, using the culvert invert as the starting elevation This is for the high flow at the top of the box culverts using the elevation above the culverts as the starting elevation	
	Discharge (cfs)	Discharge (cfs)	Discharge (cfs)
747.30	#NUM!	0.0	#NUM!
747.40	#NUM!	1.0	#NUM!
747.50	#NUM!	2.8	#NUM!
747.60	#NUM!	5.2	#NUM!
747.70	#NUM!	8.0	#NUM!
747.80	#NUM!	11.2	#NUM!
747.90	#NUM!	14.7	#NUM!
748.00	#NUM!	18.6	#NUM!
748.10	#NUM!	22.7	#NUM!
748.20	#NUM!	27.0	#NUM!
748.30	0.0	31.7	#NUM!
748.40	33.4	36.5	#NUM!
748.50	47.3	41.6	#NUM!
748.60	57.9	47.0	#NUM!
748.70	66.8	52.5	#NUM!
748.80	74.7	58.2	#NUM!
748.90	81.9	64.1	#NUM!
749.00	88.4	70.2	#NUM!
749.10	94.5	76.5	#NUM!
749.20	100.3	83.0	#NUM!
749.30	105.7	89.6	#NUM!
749.40	110.8	96.4	#NUM!
749.50	115.8	103.4	#NUM!
749.60	120.5	110.6	#NUM!
749.70	125.1	117.8	#NUM!
749.80	129.4	125.2	#NUM!
749.90	133.7	132.8	#NUM!
750.00	137.8	140.6	0.0
750.10	141.8	148.4	1.3
750.20	145.7	156.5	3.8
750.30	149.5	164.6	6.9
750.40	153.2	172.9	10.7
750.50	156.8	181.3	14.9
750.60	160.3	189.9	19.6
750.70	163.7	198.6	24.7
750.80	167.1	207.4	30.2
750.90	170.4	216.4	36.1
751.00	173.7	225.5	42.2
751.10	176.9	234.7	48.7
751.20	180.0	244.0	55.5
751.30	183.1	253.4	62.6
751.40	186.1	263.0	70.0
751.50	189.1	272.7	77.6
751.60	192.0	282.5	85.5
751.70	194.9	292.4	93.6
751.80	197.7	302.4	102.0
751.90	200.5	312.6	110.6
752.00	203.3	322.8	119.5
752.10	206.0	333.2	128.5
752.20	208.7	343.6	137.8
752.30	211.4	354.2	147.3
752.40	214.0	364.9	157.1
752.50	216.6	375.7	167.0
752.60	219.2	386.5	177.1
752.70	221.7	397.6	187.4
752.80	224.2	408.6	197.9
752.90	226.7	419.8	208.6
753.00	229.1	431.1	219.5
753.10	231.6	442.5	230.6
753.20	234.0	454.0	241.8
753.30	236.3	465.6	253.2
753.40	238.7	477.3	264.8
753.50	241.0	489.1	276.6

*contours were used from elevation 750 to 754 to determine extra discharge for the diverted discharge (the channel bypassing the inlet to the reservoir)

I:\02\jobs\02S2021\Admin\3160-H&H\13-Calculations\InflowDiversionStructure.xls




SSA MASTER PLAN - FLOODPLAINS REPORT
APPENDIX D-1
INFLOW DIVERSION CALCULATIONS FOR MONEE RESERVOIR

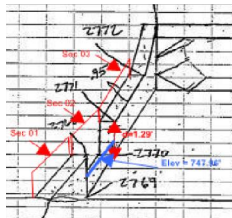Diverted Downstream Channel (south)					
Overflow Weir Control-Sec 01		Overflow Weir Control-Sec 02		Overflow Weir Control-Sec 03	
$Q_{\text{overflow}} = CLH^{3/2}$ (from p.467 Design of Small Dams)		$Q_{\text{overflow}} = CLH^{3/2}$ (from p.467 Design of Small Dams)		$Q_{\text{overflow}} = CLH^{3/2}$ (from p.467 Design of Small Dams)	
control elevation (ft)	749.30	control elevation (ft)	748.00	control elevation (ft)	749.3
C=	3.3	C=	3.3	C=	3.3
L (up to elevation 750) (ft) =	2.80	L (ft) =	5.15	L (ft) =	5.36
 <p>Sec 1 has a length of 2.80 until the discharge reaches elevation 750, then the length is increased by using contours</p>		see figure to left showing section 2 defined.		see figure to left showing section 3 defined.	
Discharge (cfs)	Weir Length (ft)	Discharge (cfs)		Discharge (cfs)	
#NUM!	2.8	#NUM!		#NUM!	
#NUM!	2.8	#NUM!		#NUM!	
#NUM!	2.8	0.0		#NUM!	
#NUM!	2.8	2.2		#NUM!	
#NUM!	2.8	6.3		#NUM!	
#NUM!	2.8	11.5		#NUM!	
#NUM!	2.8	17.7		#NUM!	
#NUM!	2.8	24.8		#NUM!	
#NUM!	2.8	32.6		#NUM!	
#NUM!	2.8	41.0		#NUM!	
#NUM!	2.8	50.1		#NUM!	
#NUM!	2.8	59.8		#NUM!	
#NUM!	2.8	70.1		#NUM!	
#NUM!	2.8	80.8		#NUM!	
#NUM!	2.8	92.1		#NUM!	
0.0	2.8	103.8		0.2	
0.3	2.8	116.1		1.0	
0.8	2.8	128.7		2.2	
1.5	2.8	141.8		3.7	
2.3	2.8	155.3		5.3	
3.3	2.8	169.2		7.2	
4.3	2.8	183.5		9.3	
8.9	4.6	198.2		11.5	
10.9	4.6	213.2		13.9	
13.0	4.6	228.6		16.4	
15.2	4.6	244.4		19.0	
17.5	4.6	260.5		21.8	
20.0	4.6	276.9		24.7	
22.5	4.6	293.7		27.7	
25.1	4.6	310.8		30.9	
27.9	4.6	328.3		34.1	
30.7	4.6	346.0		37.5	
33.6	4.6	364.1		40.9	
36.7	4.6	382.4		44.5	
39.8	4.6	401.1		48.2	
42.9	4.6	420.0		51.9	
46.2	4.6	439.2		55.8	
49.5	4.6	458.8		59.7	
52.9	4.6	478.6		63.7	
56.4	4.6	498.6		67.8	
60.0	4.6	519.0		72.0	
63.6	4.6	539.6		76.3	
67.3	43.3	560.5		80.7	
689.5	43.3	581.8		85.1	
705.7	43.3	603.1		89.6	
742.5	43.3	624.7		94.2	
779.8	43.3	646.6		98.9	
818.0	43.3	668.8		103.6	
856.6	43.3	691.2		108.5	
895.8	43.3	713.9		113.3	
935.6	43.3	736.8		118.3	
976.0	43.3	759.9		123.3	
1017.0	43.3	783.3		128.4	
1058.5	43.3	806.9		133.6	
1100.5	43.3	830.8		138.9	
1195.9	45.3	854.9		144.2	
1241.0	45.3	879.2		149.5	
1286.7	45.3	903.7		155.0	

I:\02jobs\02S2021\Admin\3160-H&H\13-Calculations\InflowDiversionStructure.xls



SSA MASTER PLAN - FLOODPLAINS REPORT
APPENDIX D-1 (CONT.)
INFLOW DIVERSION CALCULATIONS FOR MONEE RESERVOIR

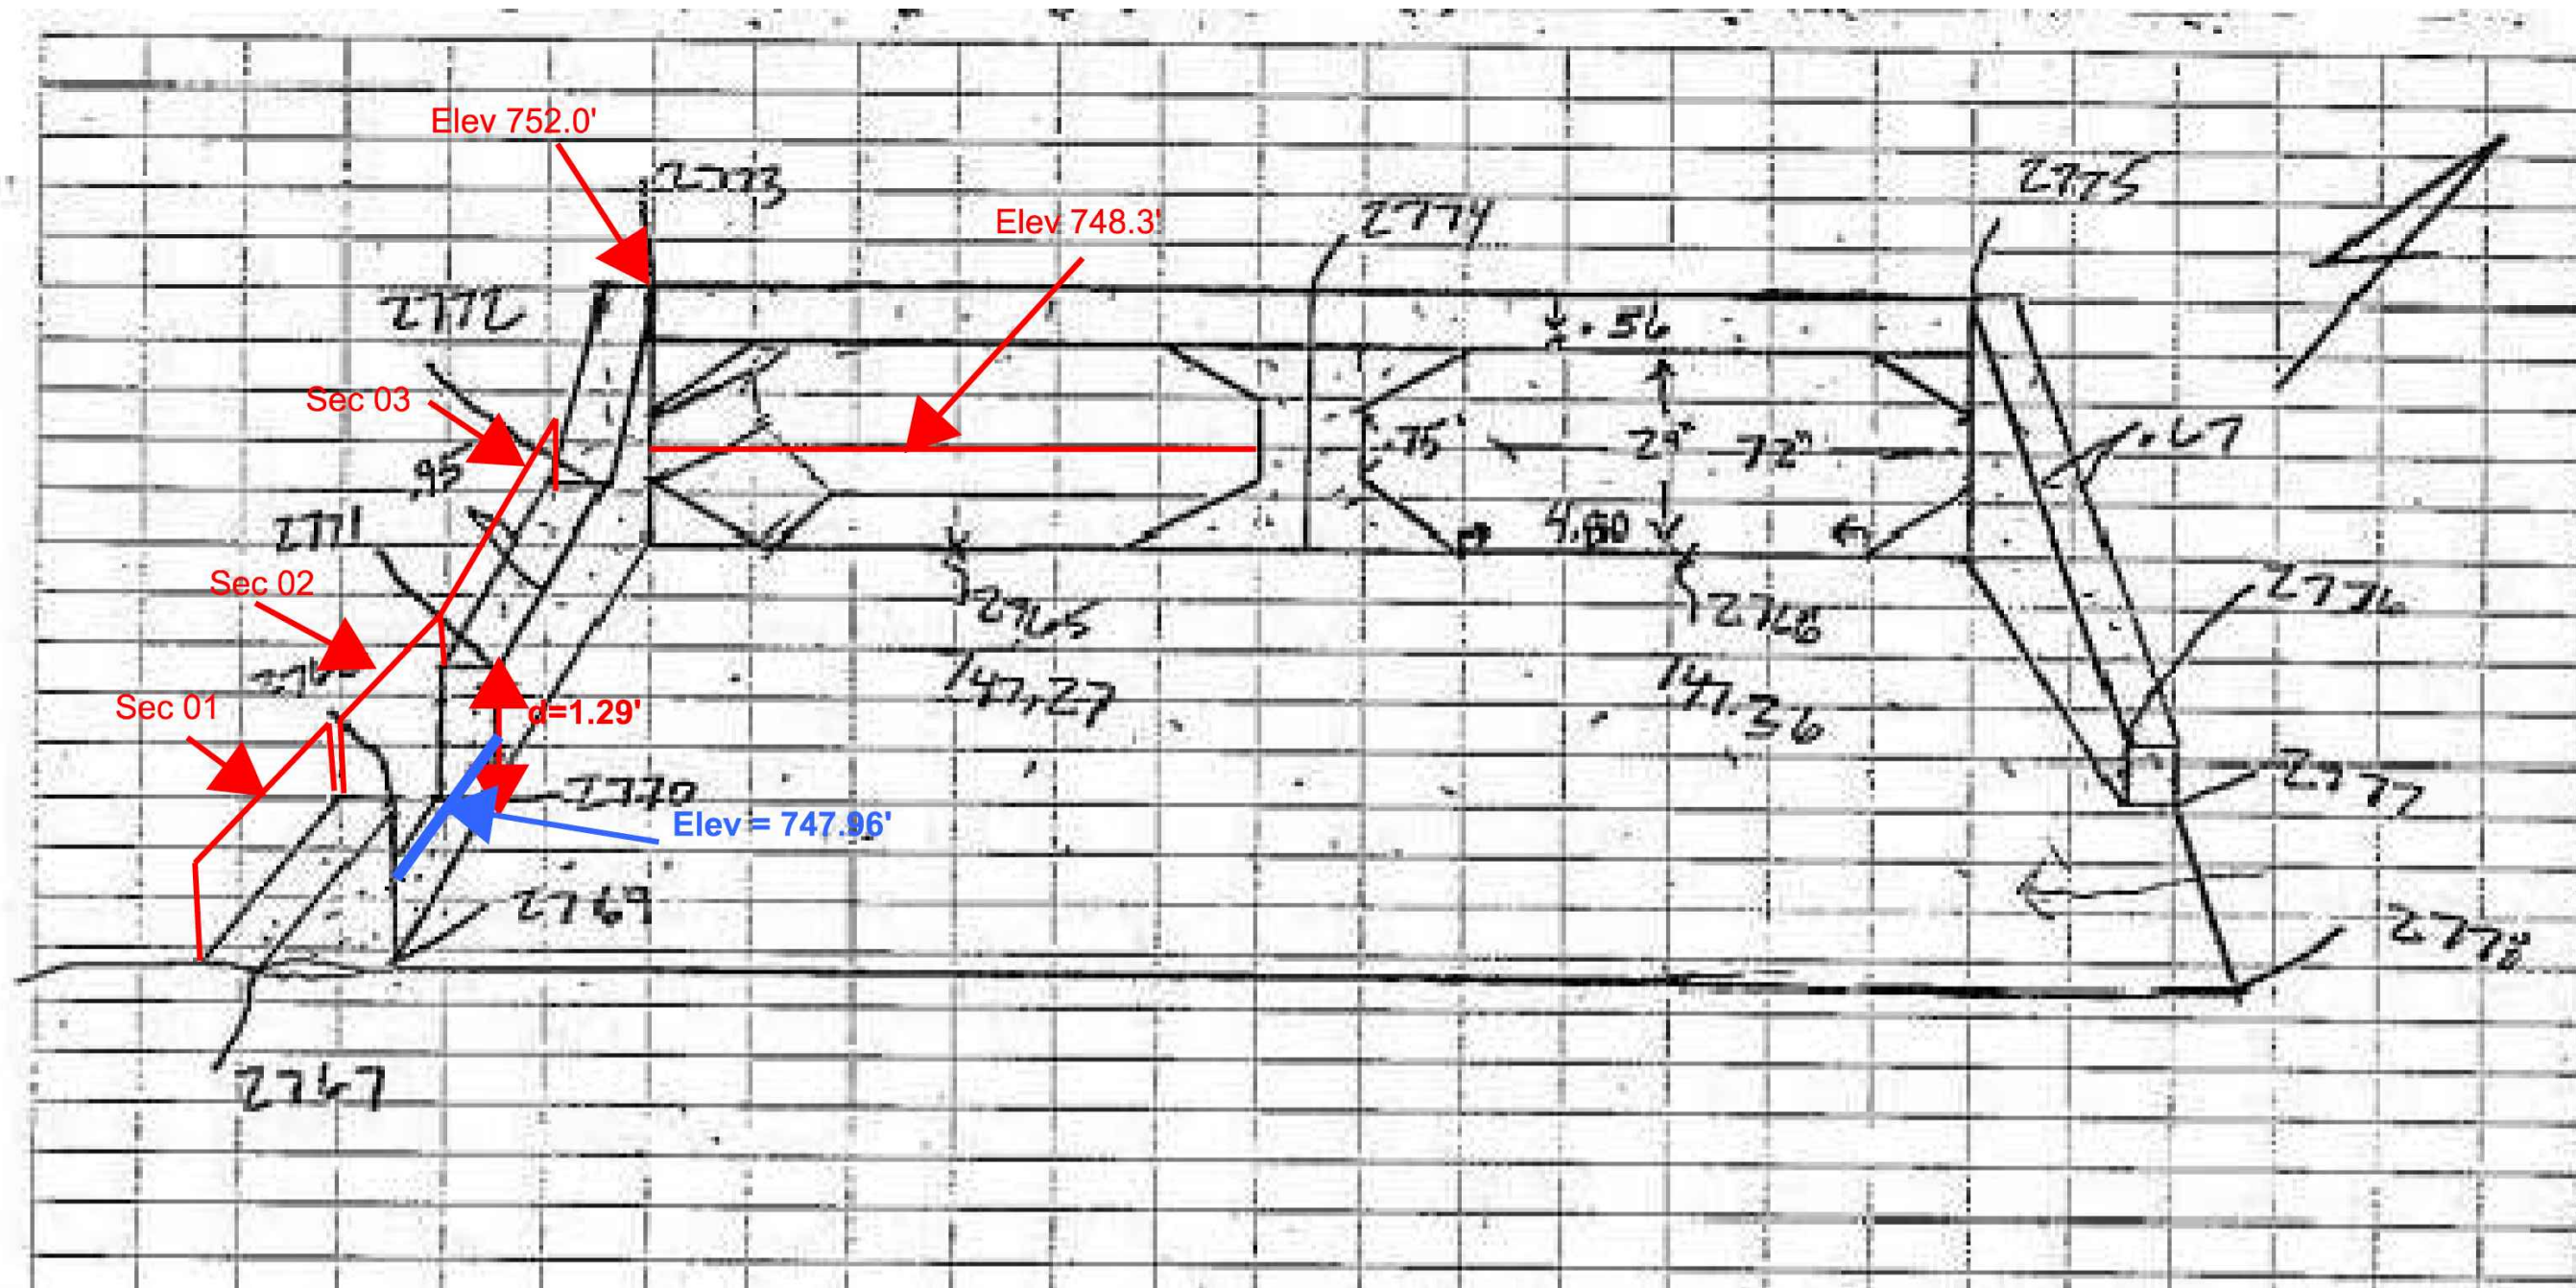

US FACE R.29

JUN 22, 2013 12:08 PM SCHED0027

DATE	SOURCE



SSA MASTER PLAN - FLOODPLAINS REPORT
APPENDIX D-1 (CONT.)
INFLOW DIVERSION CALCULATIONS FOR MONEE RESERVOIR

Input to HEC-HMS	
Total Discharge (cfs)	Diverted Discharge (cfs)
0.0	#NUM!
1.0	#NUM!
2.8	#NUM!
5.2	#NUM!
8.0	#NUM!
11.2	#NUM!
14.7	#NUM!
18.6	0.0
24.9	2.2
33.3	6.3
43.2	11.5
51.1	17.7
72.0	24.8
90.4	32.6
107.9	41.0
124.9	50.1
141.7	59.8
158.5	70.1
175.4	80.8
192.4	92.1
209.7	104.0
228.2	117.4
247.5	131.7
267.5	147.0
288.0	163.0
309.1	179.7
330.7	197.1
356.3	218.5
379.7	237.9
405.0	258.0
431.8	278.6
459.9	299.8
489.1	321.6
519.2	344.0
550.2	366.9
582.1	390.3
614.9	414.2
648.4	438.6
682.7	463.6
717.7	489.0
753.4	514.9
789.9	541.2
827.0	568.0
864.8	595.2
903.3	622.9
942.4	651.0
982.1	679.6
1589.0	1275.1
1661.7	1336.2
1735.6	1398.3
1810.6	1461.4
1886.8	1525.4
1964.0	1590.4
2042.4	1656.3
2121.8	1723.1
2202.3	1790.7
2283.9	1859.3
2366.5	1928.7
2450.1	1999.0
2534.7	2070.2
2673.1	2194.9
2761.6	2269.8
2851.2	2345.4

inlet weir control start [747.30]

diversion weir start [747.96]

inlet orifice control [748.30]

diversion overflow weir start [749.25]

inlet overflow weir start [750.00]

I:\02jobs\02S2021\Admin\3160-H&H\13-Calculations\InflowDiversionStructure.xls



SSA MASTER PLAN - FLOODPLAINS REPORT
APPENDIX D-1 (CONT.)
INFLOW DIVERSION CALCULATIONS FOR MONEE RESERVOIR



Morning Glory Structure with Trash Rack



Culvert Outlet at Monee Reservoir
Showing downstream channel

Culvert Outlet at Monee Reservoir





Inflow at Upstream End to Sediment Basin B



Diversion Weir at Upstream End



Inflow and Diversion at Upstream End of Monee before Sediment Basin B

JUN 22, 2013 12:28 PM SCH000827

RATING CURVE DERIVATION CHART - TAILWATER SET TO ELEV 728			PREPARED BY: AJM		DATE: 11/02/2010		
MORNING GLORY OUTLET STRUCTURE-MONEE RESERVOIR			CHECKED BY: SMA		DATE: 2/16/2011		
NGVD datum to NAVD datum = +0.472-ft all elevations from plans were adjusted accordingly							
		Circular Conduit		Tailwater Condition			
Normal Pool (ft)=	743.77	D _i (conduit diameter) (ft)	3.44	Downstream Inlet Invert (ft)	725.402		
Top of Dam (ft) =	750.47	D _o (conduit diameter) (ft)	3.50	TW Elevation (ft)	728.9		
Increment (ft) =	0.20	Upstream Inlet Invert (ft)	739.5				
Principal Spillway							
Overflow Weir Control		Inlet Orifice Control		Outlet Control			
Q _{overflow} = CLH ^{3/2} (from p.467 Design of Small Dams)		Q _{inlet} = CA(2gH) ^{1/2} (from p. 468, Eq(1) from Design of Small Dams)		Q _{outlet} = A(2gH _r / K _L) ^{1/2} (from p. 471 eq(7) from Design of Small Dams)			
control elevation (ft)	743.8	control elevation (ft)	739.51	control elevation (ft) =	728.900		
C=	varies	C= (usually 0.6)	0.95	a _n (net area through rack bars) =	36.9		
L (ft) =	17.59	A (ft ²) Circular =	9.28	a _g (gross area of racks & supports) =	93.9		
the L value represents an average "weir" length for very low flow for analysis purposes only				Trashrack Loss coeff. (K _t)	1.119	K _t =1.45-0.45(an/ag)-(an/ag)^2	
				Discharge coeff., C	0.95	Table 10.1 DSD pg 458 3rd ed	
				Entrance Loss coeff. (K _e)	0.11		
				Bend 1 - short radius 90 deg elbow			
				Bend Radius, R _b	4.4		
				Diameter of Bend Pipe, D	3.5		
				R _b /D =	1.3		
				Bend Loss coeff. (K _{b1})	0.200	Figure 10.12 DSD pg 459 3rd ed	
				Bend 2 - long radius 90 deg elbow			
				Bend Radius, R _b	5.3		
				Diameter of Bend Pipe, D	3.5		
				R _b /D =	1.5		
				Bend Loss coeff. (K _{b2})	0.160	Figure 10.12 DSD pg 459 3rd ed	
				Total pipe length including bends (ft)	134.25		
				Manning roughness coeff of pipe, n	0.012		
Pipe interior diameter, D _i (ft) =	3.44						
f =	0.018	f = 185n^2/(D^4/1/3)					
Friction Loss coeff. (fL/D)	0.689						
Expansion Loss coeff. (K _{ex})	0						
Contraction Loss coeff. (K _c)	0						
Gate Loss coeff. (K _g)	0.0						
Exit Velocity Head coeff. at outlet (K _e)	1.0						
Total losses (K _L) =	3.3						
Elevation - Control Elevation = H = K _L v ² /2g (from p. 456 Eq(7) from Design of Small Dams) Q = a(2gHT/K _L)^ .5							
Head (ft)	Elevation (ft) NAVD	Discharge (cfs)	Discharge (cfs)	Discharge (cfs)	INPUT TO HMS		
					Elevation Discharge		
0.00	743.77	0.0	0.0	0.0	743.77 0.00		
0.30	744.07	11.6	151.1	160.3	744.07 11.56		
0.50	744.27	24.4	154.4	161.3	744.27 24.44		
0.70	744.47	39.7	157.6	162.4	744.47 39.67		
0.90	744.67	55.6	160.7	163.4	744.67 55.58		
1.10	744.87	73.1	163.8	164.5	744.87 73.07		
1.30	745.07	90.0	166.8	165.5	745.07 89.96		
1.50	745.27	106.7	169.8	166.5	745.27 106.66		
1.70	745.47	122.8	172.7	167.5	745.47 122.83		
1.90	745.67	133.6	175.6	168.5	745.67 133.62		
2.10	745.87	141.9	178.4	169.5	745.87 141.88		
2.30	746.07	147.3	181.2	170.5	746.07 147.28		
2.50	746.27	153.0	184.0	171.5	746.27 152.99		
2.70	746.47	160.0	186.7	172.5	746.47 160.01		
2.90	746.67	169.4	189.3	173.5	746.67 169.42		
3.10	746.87	177.6	192.0	174.4	746.87 174.44		
3.30	747.07	181.4	194.5	175.4	747.07 175.41		
3.50	747.27	190.1	197.1	176.4	747.27 176.37		
3.70	747.47	196.6	199.6	177.3	747.47 177.33		
3.90	747.67	199.2	202.1	178.3	747.67 178.28		
4.10	747.87	200.1	204.6	179.2	747.87 179.23		
4.30	748.07	210.2	207.0	180.2	748.07 180.17		
4.50	748.27	215.0	209.4	181.1	748.27 181.11		
4.70	748.47	222.3	211.8	182.0	748.47 182.04		
4.90	748.67	225.2	214.1	183.0	748.67 182.97		
5.10	748.87	231.0	216.5	183.9	748.87 183.89		
5.30	749.07	236.1	218.8	184.8	749.07 184.81		
5.50	749.27	238.3	221.1	185.7	749.27 185.73		
5.70	749.47	239.4	223.3	186.6	749.47 186.64		
5.90	749.67	252.1	225.5	187.5	749.67 187.54		
6.10	749.87	265.1	227.7	188.4	749.87 188.44		
6.30	750.07	278.2	229.9	189.3	750.07 189.34		
6.50	750.27	291.5	232.1	190.2	750.27 190.23		
6.70	750.47	305.1	234.2	191.1	750.47 191.12		

DATE	SOURCE



Illinois Department of Transportation
Division of Aeronautics



SSA MASTER PLAN - FLOODPLAINS REPORT
APPENDIX D-3
OUTLET RATING CURVE FOR MONEE RESERVOIR

Interpolation (to compare to As-Built plans)						
	744.50	41.85		158.03		162.53
	745.00	83.92		165.76		165.11
	746.00	145.43		180.23		170.16
	NAVD = NGVD+0.472					
Descrip	From As-Built Plans NGVD	NAVD	Discharge	NGVD	From As-Built Plans NAVD	DISCHARGE
Weir	743.70	744.17	0	743.7	744.172	0
Weir	744.50	744.97	29	744.4	744.872	60
Weir	744.75	745.22	46	745.15	745.622	123
Weir	745.00	745.47	70	745.25	745.722	140
Weir	747.00	747.47	280	745.75	746.222	163.5
Orifice (full open)	743.70	744.17	0	746.5	746.972	200
Orifice (full open)	744.00	744.47	30	748	748.472	232
Orifice (full open)	745.00	745.47	70		750	264.60
Orifice (full open)	745.40	745.87	80			
Orifice (full open)	746.00	746.47	90			
Orifice (full open)	746.40	746.87	100			
Orifice (full open)	747.00	747.47	110			
Orifice (full open)	747.75	748.22	120			
Orifice (40% open)	743.70	744.17	0			
Orifice (40% open)	745.00	745.47	30			
Orifice (40% open)	746.00	746.47	41			
Orifice (40% open)	747.00	747.47	49			
Orifice (40% open)	747.75	748.22	52			
TW-728	743.70	744.17	0			
TW-728	744.00	744.47	280			
TW-728	745.00	745.47	290			
TW-728	746.00	746.47	298			
TW-728	747.00	747.47	305			
TW-728	747.75	748.22	310			
TW-740	743.70	744.17	0			
TW-740	744.00	744.47	140			
TW-740	745.00	745.47	158			
TW-740	746.00	746.47	170			
TW-740	747.00	747.47	183	750.00		223.45
TW-740	747.75	748.22	195			

$$Q = C_d (2\pi R_s) H_o^{3/2}$$

From Design of Small Dams (Eq 28) pg 407

Rs (radius at top of stru. **2.80**)
Elevation @ radius (ft) 743.8
P (height from radius to **4.19**)

C_d taken from Design of Small Dams figure 9-57 pg 410

P/R_s is held constant. Computed value is 1.5, for simplicity rounded up to 2


Elev (NAVD)	H _o	H _o /R _s	P/R _s	C _d	
744.10	0.30	0.107	2.00	4.00	
744.30	0.50	0.179	2.00	3.93	
744.50	0.70	0.250	2.00	3.85	
744.70	0.90	0.321	2.00	3.70	
744.90	1.10	0.393	2.00	3.60	
745.10	1.30	0.464	2.00	3.45	@ 0.45 the weir partly submerges and begins transition to orifice control
745.30	1.50	0.536	2.00	3.30	
745.50	1.70	0.607	2.00	3.15	
745.70	1.90	0.679	2.00	2.90	
745.90	2.10	0.750	2.00	2.65	
746.10	2.30	0.821	2.00	2.40	
746.30	2.50	0.893	2.00	2.20	
746.50	2.70	0.964	2.00	2.05	
746.70	2.90	1.036	2.00	1.95	@ 1.0 the weir is completely submerged and acts as an orifice
746.90	3.10	1.107	2.00	1.85	
747.10	3.30	1.179	2.00	1.72	
747.30	3.50	1.250	2.00	1.65	
747.50	3.70	1.321	2.00	1.57	
747.70	3.90	1.393	2.00	1.47	
747.90	4.10	1.464	2.00	1.37	
748.10	4.30	1.536	2.00	1.34	
748.30	4.50	1.607	2.00	1.28	
748.50	4.70	1.679	2.00	1.24	
748.70	4.90	1.750	2.00	1.18	
748.90	5.10	1.821	2.00	1.14	
749.10	5.30	1.893	2.00	1.10	
749.30	5.50	1.964	2.00	1.05	
749.50	5.70	2.036	2.00	1.00	
749.70	5.90	2.107	2.00	1.00	
749.90	6.10	2.179	2.00	1.00	
750.10	6.30	2.250	2.00	1.00	
750.30	6.50	2.321	2.00	1.00	
750.50	6.70	2.393	2.00	1.00	




SSA MASTER PLAN - FLOODPLAINS REPORT
APPENDIX D-3 (CONT.)
OUTLET RATING CURVE FOR MONEE RESERVOIR

STRUCTURE R1 ON ROCK CREEK

Traffic Barrier Terminal, Type SA (Typ.)
See Std. 2340 for details

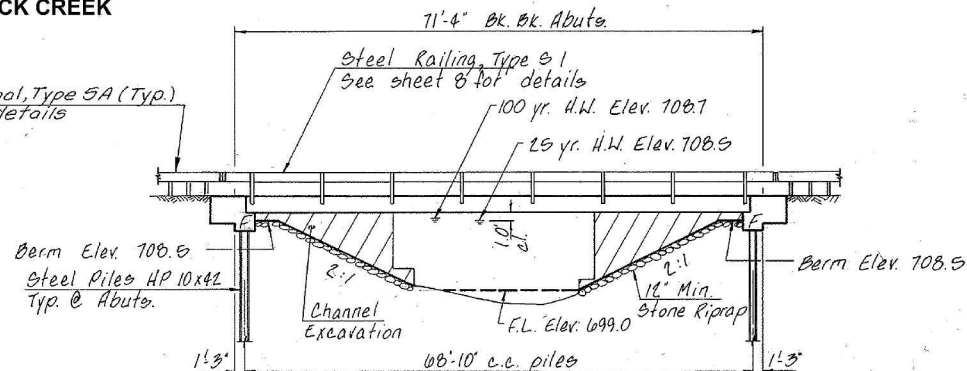

ELEVATION

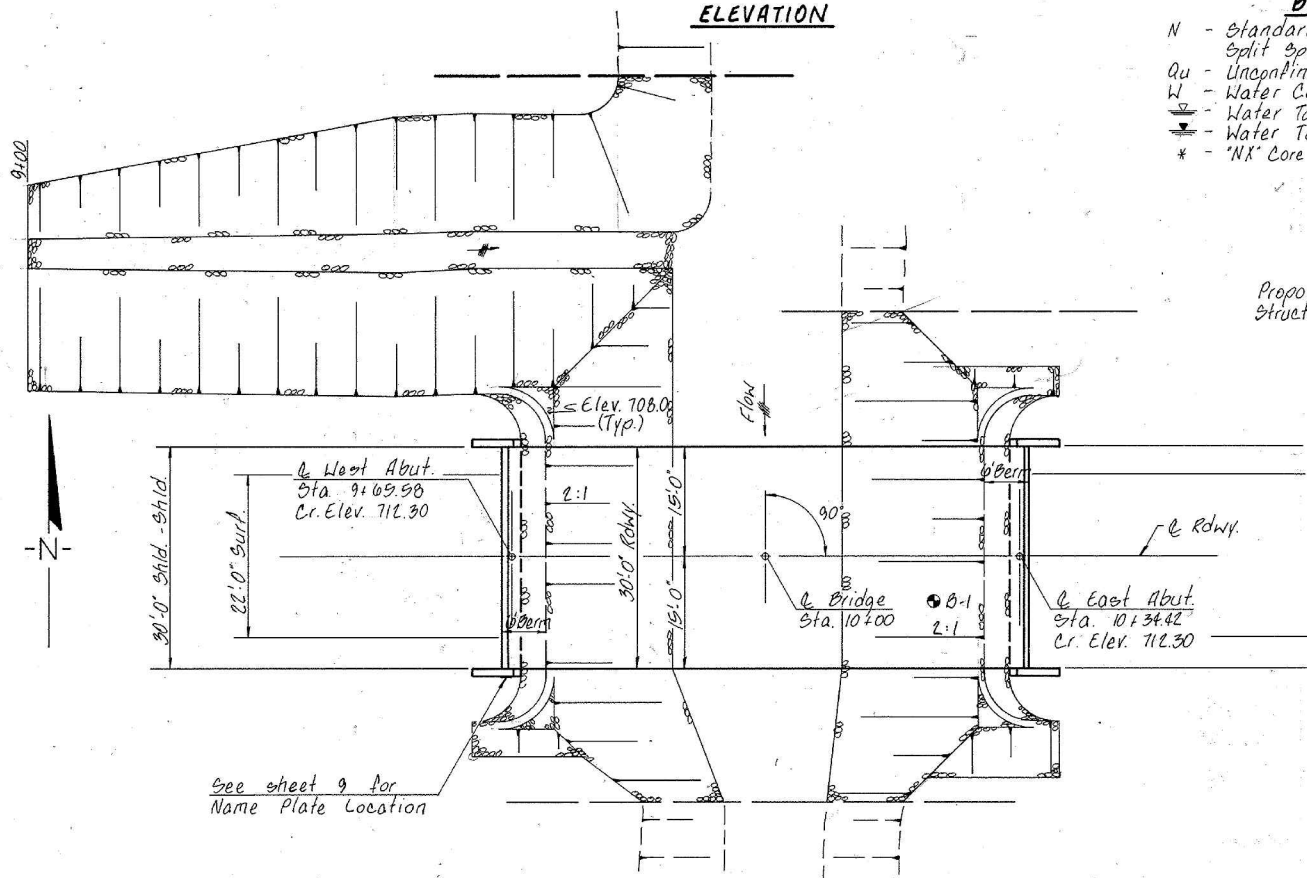

GENERAL NOTES

The contractor shall drive one steel test pile in a permanent location at the West Abut. as directed by the Engineer, before ordering the remainder of the piles.

WATERWAY DATA

Drainage Area	10.30 sq. Mi.
Existing Opening (25 yr.)	250 sq. ft.
Required Opening (25 yr.)	300 sq. ft.
Proposed Opening (25 yr.)	380 sq. ft.
Design Discharge (25 yr.)	1030 CFS
Created Head (25 yr.)	0.2 ft.
100 yr. Discharge	1340 CFS
100 yr. Created Head	0.4 ft.
Construction Permits: The requirements of the Division of Water Resources have been fulfilled in accordance with Statewide Permit No. 2	

DESIGN STRESSES

f'c	= 5,000 psi (Prestressed Beams)
f'ci	= 4,950 psi (Prestressed Beams)
f'c	= 1,400 psi (Class X Concrete)
f's	= 270,000 psi (Prestressed Strands)
f'si	= 189,000 psi (Prestressed Strands)
f's	= 20,000 psi (Reinf. Bars - Field Units)
f'y	= 60,000 psi (Reinf. Bars - Precast Units)
n	= 9 (Class X Concrete)
LOADING: HS 20-44	
Design Specifications: AASHTO 1983 & 1984, BS Interims	
25% sq. ft. included in dead load for future wearing surface.	


I certify that to the best of my knowledge, information and belief, that this bridge design is structurally adequate for the design loading shown on the plans. The design is an economical one for the style of structure and complies with requirements of the current AASHTO standard specifications for Highway Bridges.

Frederick J. Stone Jr.
Illinois Structural No. 2934

ROCK CREEK
BUILT 198- BY
WILL ROAD DISTRICT
WILL COUNTY
SEC. 85-22102-00-BR
STR. NO. 099-4953
LOADING HS20
LETTERING FOR NAME PLATE
See Std. 2113

BORING DATA

- N - Standard Penetration Test. Blows per foot to drive 2" O.D. Split Spoon Sampler 30" with 140# hammer falling 30"
- Qu - Unconfined Compressive Strength - Tied
- W - Water Content - percentage of oven dry weight - %
- WT - Water Table while drilling
- WT - Water Table after completion
- * - "N" Core 100% Recovery 0% R.Q.D.

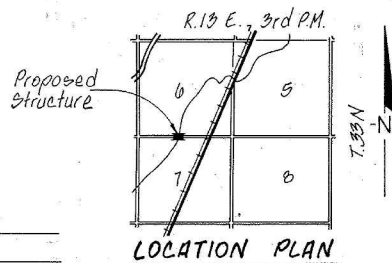

ROUTE NO.	SECTION	COUNTY	TOTAL SHEETS	SHEET NO.
85-22102-00-BR	00-BR	WILL	9	0
FED. ROAD DIST. NO. 7 ILLINOIS PROJECT				

DEPTH	SOIL DESCRIPTION
10' - 108.2	FILL - SAND & GRAVEL
11' - 107.9	FILL - Brown silty CLAY
12' - 107.7	Firm brown and gray silty LOAM, moist
13' - 107.1	Firm gray SAND and GRAVEL, wet (saturated)
14' - 106.9	Very tough gray CLAY, moist
15' - 106.7	Dense gray LOAM, moist
16' - 106.5	Firm gray SAND, very moist
17' - 106.3	Firm gray sandy LOAM, moist
18' - 106.1	Tough gray CLAY, moist
19' - 105.9	Firm gray SAND, wet (saturated)
20' - 105.7	Hard to very tough gray CLAY, moist
21' - 105.5	Firm gray SAND, wet (saturated)
22' - 105.3	Hard gray LIMESTONE with SAND BEAMS

BORING NO. 1

at Rt. Sta. 10+23

TOTAL BILL OF MATERIAL

ITEM	UNIT	SUPER	SUB	TOTAL
Precast Prestressed Concrete Deck Beams (21" Depth)	Sq. Ft.	2,100		2,100
Class X Concrete	Cu. Yd.		18.8	18.8
Reinforcement Bars	Pound		2,440	2,440
Steel Railing, Type S1	Lin. Ft.	151		151
Steel Piles HP 10x42	Lin. Ft.		432	432
Test Pile Steel HP 10x42	Each		1	1
Name Plates	Each		1	1
Bit. Conc. Surface Course, Mix. O. C. I	Ton	20		20
Leveling Binder (Machine Method)	Ton	0		0
Bituminous Materials (Prime Coat)	Gallon	19		19
Stone Riprap	Sq. Yd.			730

GENERAL PLAN & ELEVATION

SECTION 85-22102-00-BR
WILL ROAD DISTRICT
WILL COUNTY
STATION 10+00

COLLINS AND RICE
CONSULTING ENGINEERS

DESIGNED F.S.
DRAWN R.N.

CHECKED M.B.
DATE 7-23-80 NO. 2120



Illinois Department of Transportation
Division of Aeronautics



SSA MASTER PLAN - FLOODPLAINS REPORT
APPENDIX D-4
AS BUILT/ RECORD DRAWINGS FOR MONEE RESERVOIR

STRUCTURE R1 ON ROCK CREEK

30'-0" f-f rail
15'-0" 15'-0"
Rdwy. & Symm.
Slope 3 3/4" in 15'-0"
4" ft.
11" Bit. Conc. Surf. Crse., Mix. O.; C.I.I.
Leveling Binder (Machine Method) as Required.
10 Beams @ 3'-0" = 30'-0"
Int. Brg. Pad
Ext. Brg. Pad

CROSS SECTION

9'-0" 9'-0"
50 - #4 bars A1 @ 14" cts. Top
50 - #3 bars U1 @ 14" cts. Bottom
4 - #4 bars A1 @ 8" cts. Top Each End
4 - #4 bars U1 @ 8" cts. Bottom Each End
3" Holes for Tie Rods. See Detail
Lifting Loops 2 Each End
6" Typ.
3/4" Drain Holes - Bottom
6" Typ.
4" Vent Holes - Top
7" 2" Holes for Dowel Rods Each End
2'-0" 32'-0" 32'-0" 2'-0"
70'-0"

TYPICAL PLAN OF BEAMS

1'-5 1/2" 7 Spaces @ 9'-7" = 67'-1"
See sheet 8 for Rail Post Insert Details.
3 3/4" Typ.
1 3/4" Typ.

ELEVATION OF OUTSIDE BEAMS
Showing Rail Post Spacing

Key
2'-1"
3 1/2" 1'-6" 3 1/2"
3" Holes
3" Hole
Outside edge of ext. beam
1'-0 1/2"
9" 3 1/2"
3" Hole
INTERIOR (18 Req'd)
EXTERIOR (4 Req'd)
BEARING PAD DETAILS

2'-9" o. to o.
8" 2 1/2" 12" 2 1/2" 8"
1'-7"
1'-9"
2'-9" o. to o.
BAR A1
BARS U1 & U2

4" x 4" x 1/2" Plate Washer 2 Required
Full thread sleeve 3" long 9 Required
3" Opening
Nut for 1" Rod 2 Required
1" x 2'-11" Rods (Thread Each End 4") 10 Required

TRANSVERSE TIE ROD DETAIL

Note: A Calcium Nitrite corrosion inhibitor as covered in the Special Provisions, shall be used in the concrete for prestressed beams.

NOTES
Required Release Strength, f_{ci}, shall be 4950 p.s.i.
Prestressing steel shall be non-galvanized high strength, stress-relieved 7-wire strand, Grade 270.
The nominal diameter shall be 1/2" and the nominal cross-sectional area shall be 0.153 sq. in.
Lifting Loops shall be 7-wire stress-relieved, 2'-1/2" - 270 ksi strands.
The 1" rods in the transverse tie assembly shall be tightened to a snug fit & the threads set. Pockets that receive the tie rods on outside shall be filled with grout after ties are in place.
Reinforcement bars shall conform to AASHTO: M-31 or M-53, Grade 60.
The bearing seat surfaces shall be adjusted by shimming to assure firm and even bearing. Two 1/2" fabric adjusting shims of the dimensions of the Exterior Bearing Pad shall be provided for each bearing.
Keyway surfaces shall be cleaned to remove form oil and other bond breaking material prior to shipment of the beams. Cleaning shall be done by sandblasting the keyway areas between top of the beam and the bottom edge of the key.
An equal substitution of the low-relaxation strands for the stress-relieved strands will be permitted.

2 1/2" x 1/2" Prem. Jt. Filler full width of bridge.
1/2" Fabric Brg. Pad
3" x 1'-6" Dowel Rods
After beams are in place drill 1 1/2" holes in cap & grout dowel rods in place.
Rods to be grouted and allowed to cure (Min. 24 Hrs.) prior to grouting the shear keys.

SECTION AT ABUTMENTS

NOTE: Omit key on exterior face of outside beams.

36" 27" 4 1/2"
2 - #5 bars, full length of beam
4 - #5 bars Each End (14'-0" long)
2 - #3 bars A evenly spaced between A1 bars between end blocks (2'-8" long)
4 - #3 bars A @ 14'-0" cts. Each End
2 Strands
2 Strands
7 Strands
8 Strands
4 - #4 bars, full length of beam
4 - #4 bars A1 @ 14" cts.
3 - #3 bars U1 @ 14" cts.
3/4" Chamfer
Typ. Typ.

TYPICAL SECTION THRU BEAM

14 - 1/2" Strands Stressed to 28,900 Lbs. Each
Place strands symmetrically about C of beam.
Use Standard Grid Pattern.

45° min. angle of lift
3" Radius (Cold Bent)
Top of Beam
14" 4" min.
6"
Note: The loop shall be formed in a manner such that all strands are engaged during lifting. Loops shall be burned off after beams have been erected.

LIFTING LOOP DETAIL

Approved alternate may be substituted for the above.


BILL OF MATERIAL

ITEM	UNIT	QUANTITY
Precast Prestressed Concrete Deck Beams (27" Depth)	Sq. Ft.	2,100
Bit. Conc. Surf. Crse., Mix. O.; C.I.I.	Ton	20
Leveling Binder (Machine Method)	Ton	8
Bituminous Materials (Prime Coat)	Gallon	19


SUPERSTRUCTURE
SECTION 85-22102-00-BR
WILL ROAD DISTRICT
WILL COUNTY
STATION 10+00
COLLINS AND RICE
CONSULTING ENGINEERS
DESIGNED F.B.
DRAWN R.N.
CHECKED M.B.
DATE 7-13-06 NO 2120

STRUCTURE R1 ON ROCK CREEK


ROUTE NO.	SECTION	COUNTY	TOTAL SHEETS	SHEET NO.
85-22102	-00-BR	WILL	9	8
FED. ROAD DIST. NO. 7	ILLINOIS	PROJECT		

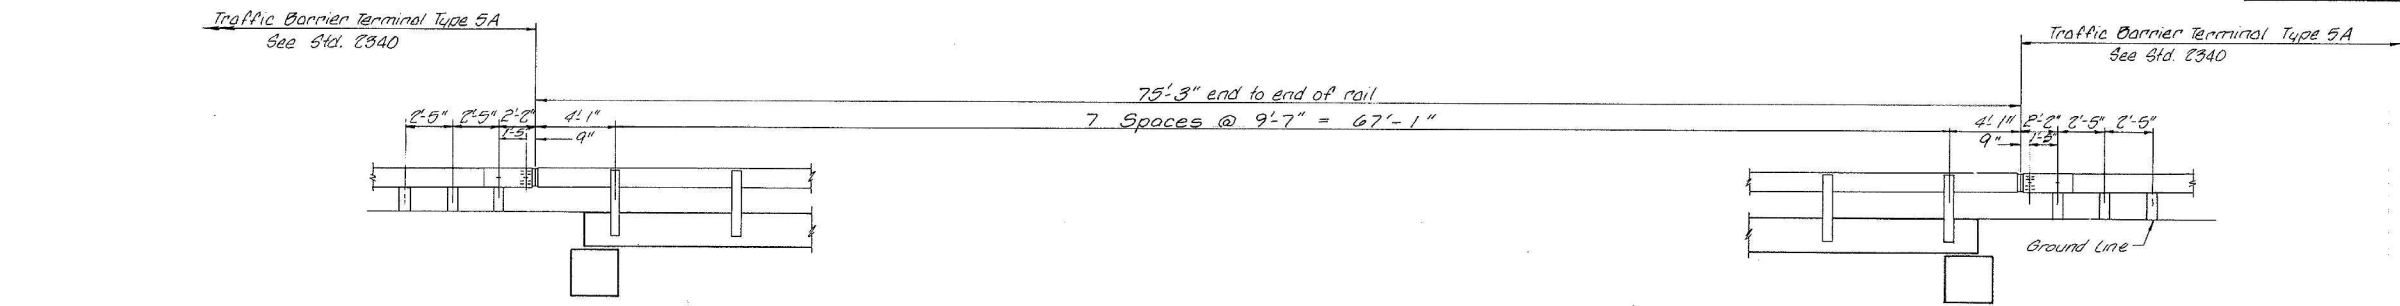

ELEVATION

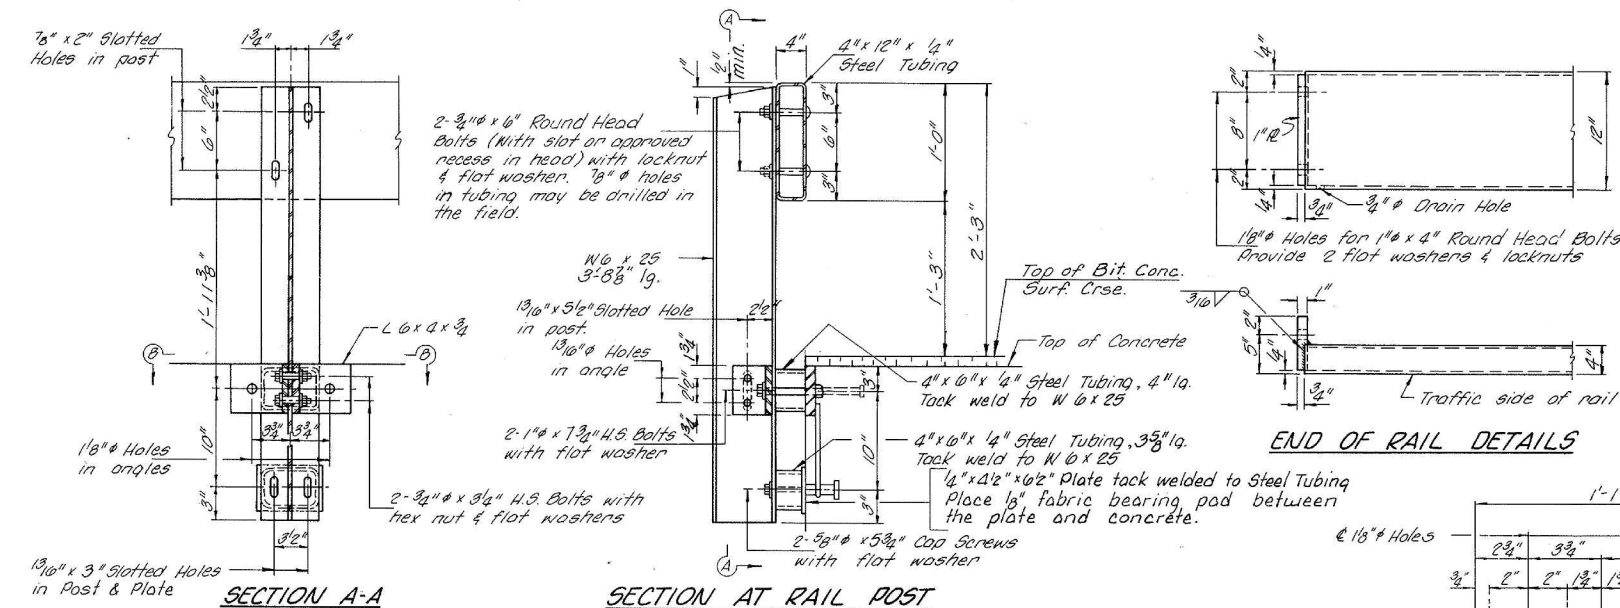

END OF RAIL DETAILS

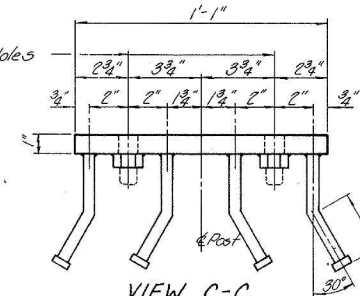

NOTES

Hollow structural steel tubing shall conform to the requirements of A.S.T.M. designation A-500 Grade B Structural Steel Tubing.

All other steel shapes and plates shall conform to the requirements of A.A.S.H.T.O. designation M-183 except posts and angles shall conform to A.A.S.H.T.O. M-223, Grade 50.

Bolts, cap screws, and nuts shall conform to the requirement of A.S.T.M. designation A-307 except for high strength bolts, nuts and washers noted which shall conform to A.A.S.H.T.O. designation M-104.

All bolts, nuts, cap screws, washers and lock washers shall be galvanized in accordance with A.A.S.H.T.O. designation M-232.

All posts, railing, rail splices, anchor devices and angles shall be galvanized after shop fabrication in accordance with A.S.T.M. A-335 and A.A.S.H.T.O. M-111. Galvanized rail shall not be painted.

Railing shall be in accordance with Section 508 of the Standard Specifications, except as noted, and shall be paid for at the contract unit price per linear foot for STEEL RAILING, TYPE S-1.

All field drilled holes shall be coated with an approved zinc rich paint before erection.

The 3/4" high strength bolts used to connect the 6" x 4" x 3/4" angles to the post shall be tightened in accordance with Art. 507.04(g)(3) of the Standard Specifications. The 1" high strength bolts connecting the angles to the concrete shall be tightened to a snug fit and given an additional 1/8 turn. The 5/8" cap screws in bottom of posts shall be tightened to a snug fit only, after the 3/4" high strength bolts have been tightened in accordance with Article 507.04(g)(3).

BILL OF MATERIAL


Item	Unit	Quantity
Steel Railing, Type S-1	Lin. Ft.	151

RAILING DETAILS


SECTION 85-22102-00-BR
WILL ROAD DISTRICT
WILL COUNTY
STATION 10+00

COLLINS AND RICE
CONSULTING ENGINEERS

DESIGNED F.S. CHECKED M.B.
DRAWN R.N. DATE 7-23-06 NO. 2126

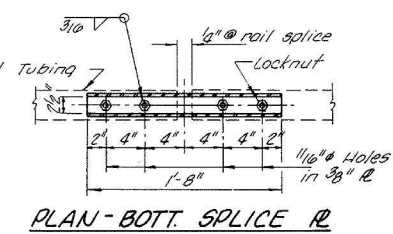

SECTION AT RAIL SPLICE

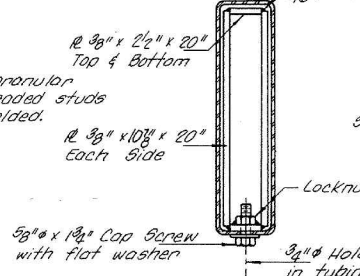

ANCHOR DEVICE

* Threaded areas shall be plugged or blocked off during casting of beam.

** Whenever the lower insert assemblies interfere with strand locations, the #3 bars shall be cut and adjusted in order to allow raising or lowering of the lower inserts. Maximum adjustment not to exceed 1/2".




Illinois Department of Transportation
Division of Aeronautics




SSA MASTER PLAN - FLOODPLAINS REPORT
APPENDIX D-4 (CONT.)
AS BUILT/ RECORD DRAWINGS FOR MONEE RESERVOIR

ROUTE NO.	SECTION	COUNTY	TOTAL SHEETS	SHEET NO.
TR. 275A	85-22102-00-BR	WILL	9	9
FED. ROAD DIST. NO. 7	ILLINOIS	PROJECT		

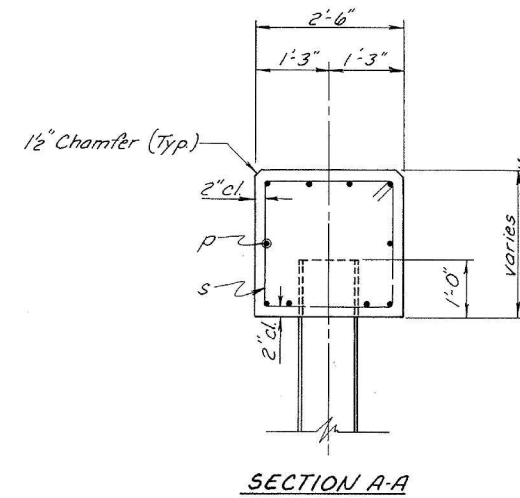

BAR 4

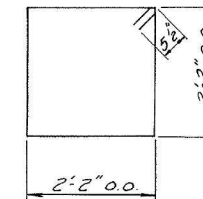

Technical drawing of a pile cap and pile foundation. The drawing shows a cross-section of a pile cap with dimensions and elevations. The cap is 5'-10" high and 4'-6" wide. It is supported by four piles. The elevations are: Elevation 709.74 at the top of the cap, Elevation 711.99 at the top of the cap, Elevation 709.40 at the top of the cap, Elevation 707.90 at the top of the cap, and Elevation 700.90 at the bottom of the cap. The drawing also shows the reinforcement details: 10-#7 bars p, 4-#6 bars u, 3-#5 bars s, and 10-#5 bars s @ 12" typ. between piles. The spacing between the piles is 4 pile spaces @ 7'-0" = 28'-0".

Hand-drawn cross-section diagram of a reinforced concrete wall. The wall has a total height of 4'-1" and a total width of 5'-0". It is reinforced with 4 #4 bars on each face, spaced at 12" on center. The diagram shows the wall's profile with reinforcement bars extending into the concrete. A section line A-A is indicated on the right side. The bottom of the wall is labeled "Concrete outside const it".

Concrete outside const. jt. -
to be poured after
superstructure is in place.

Name Plate shall be placed on the outside face South Wing, West Abut

BAR	No. REQD	SIZE	LENGTH	SHAPE
H	10	#4	5'-10"	—
H ₁	10	#4	4'-9"	—
P	20	#7	32'-2"	—
S	60	#5	9'-7"	□
L	10	#6	12'-1"	—
V	48	#4	3'-10"	—

Class X Concrete	Cu. Yd.	18.8
Reinforcement Bars	Pound	2440
Steel Piles HP10x42	Lin. Ft.	432
Test Pile Steel HP10x42	Each	1
Name Plate	Each	1

Type _____ Steel HP 10x42
No. Req'd. (2 Abut.) _____ 10*
Capacity _____ Drive to Refusal
Est. Length _____ 48 Feet/Pile

* Includes one test pile in a permanent location at the West Abut.


SECTION 89-2202-00-BR
WILL ROAD DISTRICT
WILL COUNTY
STATION 10100

COLLINS AND RICE
CONSULTING ENGINEERS


DESIGNED *F.G.* CHECKED *M.D.*
DRAWN *R.N.* DATE *7-23-80* NO. *2120*

BENCHMARKS


BM: SOUTHWEST CORNER OF
SOUTHWEST WINGWALL
(ORANGE PAINT)
ELEVATION 705.46

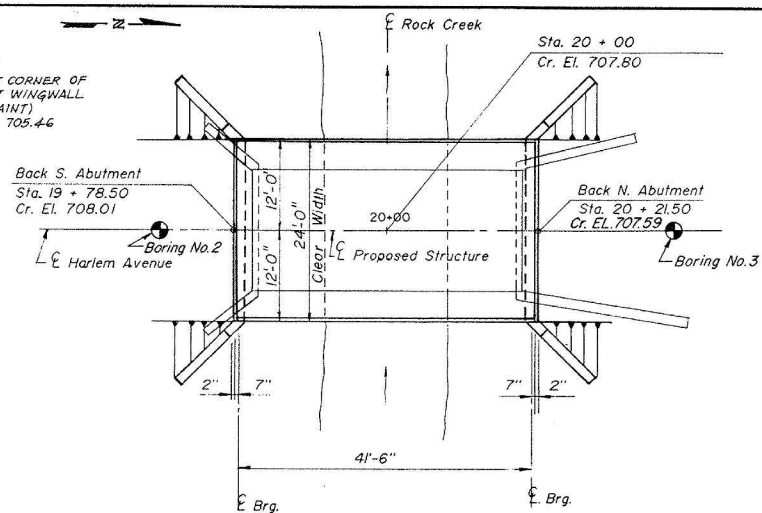

PLAN
Scale: 1" = 10'

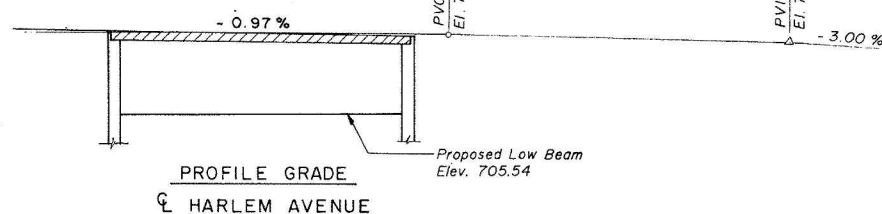


PROFILE GRADE
HARLEM AVENUE

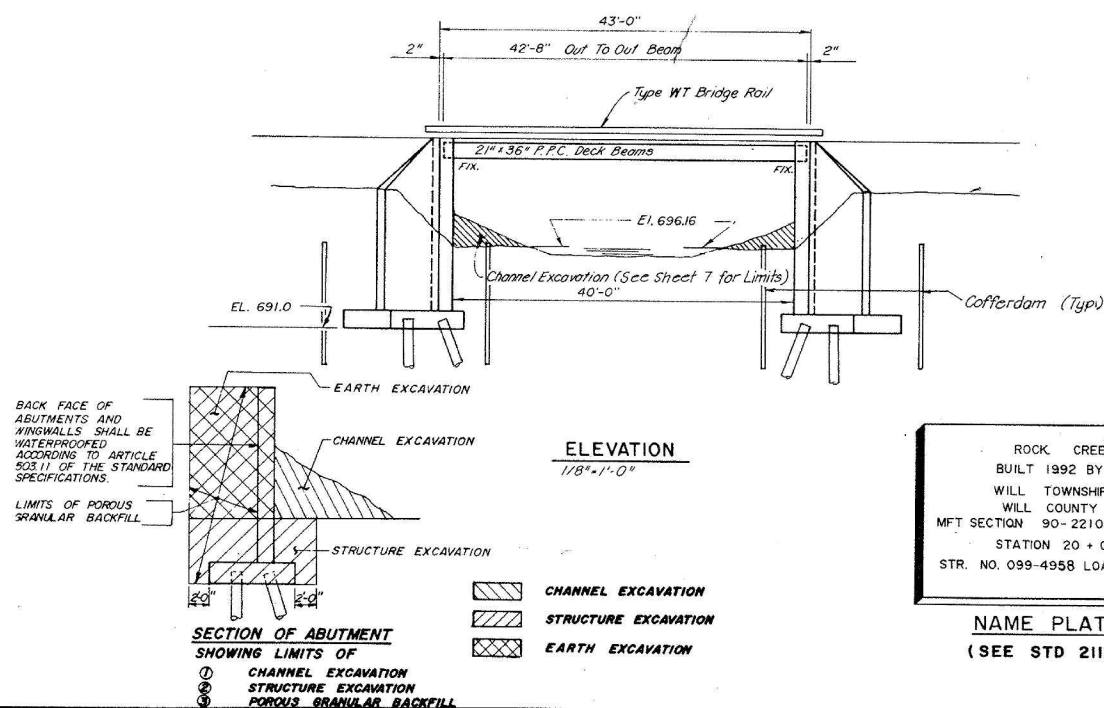

ROCK CREEK
BUILT 1992 BY:
WILL TOWNSHIP
WILL COUNTY
MFT SECTION 90-22108-00-BR
STATION 20 + 00
STR. NO. 099-4958 LOADING HS20

NAME PLATE
(SEE STD 2113)

STRUCTURE R4 ON ROCK CREEK

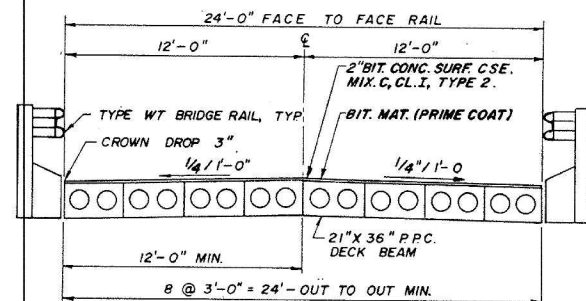

TYPICAL CROSS SECTION

BILL OF MATERIAL (BRIDGE)

ITEM	UNIT	QUANTITY		
		SUPER	SUB.	TOTAL
PCC MORTAR FAIRING COURSE	LIN. FT.	344	—	344
WATERPROOF MEMBRANE SYSTEM	SQ. YD.	115	—	115
CLASS X CONCRETE	CU. YD.	—	112	112
REMOVAL OF EXISTING STRUCT.	EA.	—	—	1
PRECAST PRESTRESSED CONCR. DECK BEAMS (21" DEPTH)	SQ. FT.	1024	—	1024
STEEL RAILING TYPE WT	LIN. FT.	86	—	86
BIT. MATERIALS (PRIME COAT)	GAL.	120	—	120
REINFORCEMENT BARS, EPOXY COATED	POUND	—	7620	7620
BITUMINOUS CONCRETE SURFACE COURSE MIXTURE C, CLASS 1, TYPE 2	TON	35	—	35
NAME PLATE	EA.	1	—	1
STRUCTURE EXCAVATION	CU. YD.	—	420	420
CHANNEL EXCAVATION	CU. YD.	—	45	45
POROUS GRANULAR BACKFILL	CU. YD.	—	300	300
COFFERDAM	EACH	—	2	2
COFFERDAM EXCAVATION	CU. YD.	—	120	120
TEST PILES STEEL HP 10x42	EA.	—	2	2
FURNISHING STEEL PILES HP 10x42	LIN. FT.	—	1702	1702
REINFORCEMENT BARS	POUND	—	4960	4960
DRIVING STEEL PILES	LIN. FT.	—	1702	1702
METAL SHOES	EA.	—	48	48

I CERTIFY THAT TO THE BEST OF MY KNOWLEDGE, INFORMATION AND BELIEF, THIS BRIDGE DESIGN IS STRUCTURALLY ADEQUATE FOR THE DESIGN LOADING SHOWN ON THE PLANS. THE DESIGN IS AN ECONOMIC ONE FOR THE STYLE OF STRUCTURE AND COMPLIES WITH REQUIREMENTS OF THE CURRENT "AASHTO STANDARD SPECIFICATIONS FOR HIGHWAY BRIDGES".

ANTONIO TIVERIOS
ILLINOIS REGISTERED STRUCTURAL
ENGINEER NO. 2150



4-25-91
DATE

NO.	DATE	REVISION	BY

SHEET NO.	SECTION	COUNTY	TOTAL SHEETS	SHEET NO.
		WILL	7	2
PROJ. ROAD DIST. NO. 7	ILLINOIS	PROJ. AID PROJECT		

EXISTING STRUCTURE

THE EXISTING SUPERSTRUCTURE IS TO BE REMOVED. STEEL PONY TRUSS BRIDGE WITH WOOD DECK, 35 FT. LONG AND APPROXIMATELY 16' WIDE, ABUTMENTS AND WINGS ARE CONSTRUCTED OF CUT STONE

DESIGN SPECIFICATIONS

CONSTRUCTION PROCEDURES SHALL BE IN ACCORDANCE WITH THE ILLINOIS DEPARTMENT OF TRANSPORTATION "STANDARD SPECIFICATIONS FOR ROAD AND BRIDGE CONSTRUCTION" ADOPTED JULY 1, 1988

WATERWAY INFORMATION

DRAINAGE AREA:	11 SQ. MI.
DESIGN DISCHARGE (15 YEAR):	1191 CFS
EXISTING OPENING:	263 SQ. FT.
REQUIRED OPENING:	322 SQ. FT.
PROPOSED OPENING:	334 SQ. FT.
CREATED HEAD FOR 15 YEAR FLOOD:	0 FT.
100 YEAR DISCHARGE:	1844 CFS
CREATED HEAD FOR 100 YEAR FLOOD:	0 FT.

DESIGN STRESSES

PRECAST PRESTRESSED CONCRETE UNITS 1/2" STRAND

f'c = 5,000 psi
f'ci = 4,000 psi
f's = 270,000 psi
f'si = 189,000 psi

SUBSTRUCTURE

f'c = 3,500 psi, f'c = 1000 PSI
f'y = 60,000 psi, f's = 24,000 PSI

DESIGN SPECIFICATION: 1989 AASHTO STANDARD SPECIFICATION AND ALL SUBSEQUENT INTERIMS AS APPLICABLE.

LOADING HS 20-44

THIS STRUCTURE WAS DESIGNED WITH AN ALLOWANCE OF 25/FT.² FOR A FUTURE WEARING SURFACE.

GENERAL NOTES:

- SEE PROPOSAL FOR BORING DATA.
- REINFORCEMENT BARS SHALL CONFORM TO THE REQUIREMENTS OF AASHTO M-31 GRADE 60.
- BACKFILL SHALL BE PLACED BEHIND THE ABUTMENT AFTER THE SUPERSTRUCTURE HAS BEEN POURED AND THE FALSEWORK REMOVED. SEE ARTICLE 502.11 OF THE STANDARD SPECIFICATIONS.
- THE BACK FACE OF CLOSED ABUTMENTS & WING WALLS SHALL BE WATERPROOFED ACCORDING TO ARTICLE 503.11 OF THE STANDARD SPECIFICATIONS.
- THE TOP SURFACE OF THE BEAMS SHALL BE FINISHED IN ACCORDANCE WITH ARTICLE 505.06 OF THE STANDARD SPECIFICATION EXCEPT THAT THE SURFACE SHALL NOT BE ROUGHENED BY BROOMING. THE FINISHED SURFACE SHALL BE FREE OF DEPRESSIONS OR HIGH SPOTS WITH SHARP CORNERS, AND THE TOP EDGE OF KEYS SHALL BE ROUNDED OR CHAMFERED A MINIMUM OF 1/4".
- A CALCIUM NITRITE CORROSION INHIBITOR, AS COVERED IN THE SPECIAL PROVISIONS, SHALL BE USED IN THE CONCRETE FOR PRECAST PRESTRESSED CONCRETE DECK BEAMS.
- THE CONTRACTOR SHALL DRIVE ONE STEEL HP 10x42 TEST PILE IN A PERMANENT LOCATION AT EACH ABUTMENT AS DIRECTED BY THE ENGINEER BEFORE ORDERING THE REMAINDER OF PILES.

DEPARTMENT OF TRANSPORTATION
GENERAL PLAN AND ELEVATION

MFT SECTION 90-22108-00-BR
STATION 20+00
WILL TOWNSHIP, WILL COUNTY

McDonough Associates Inc.
Engineers / Architects

DESIGNED BY: RKT
CHECKED BY: SHZ
DRAWN BY: KUC








Illinois Department of Transportation
Division of Aeronautics



SSA MASTER PLAN - FLOODPLAINS REPORT
APPENDIX D-4 (CONT.)
AS BUILT/ RECORD DRAWINGS FOR MONEE RESERVOIR

STATE OF ILLINOIS
DEPARTMENT OF TRANSPORTATION
STRUCTURE R4 ON ROCK CREEK

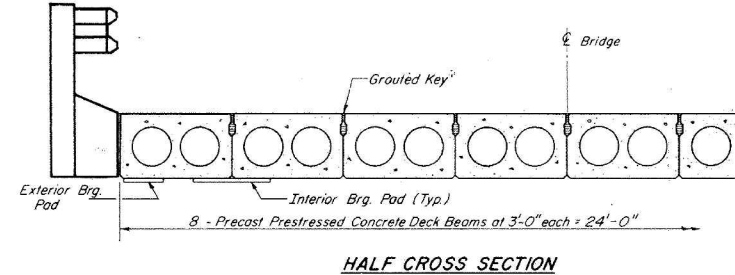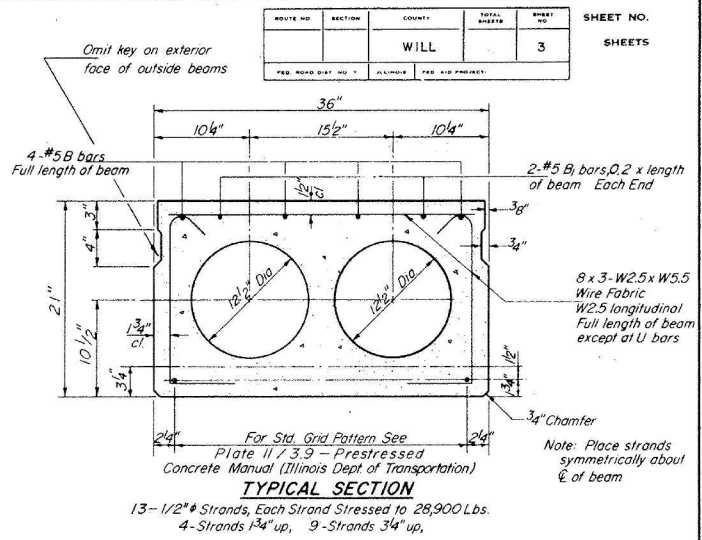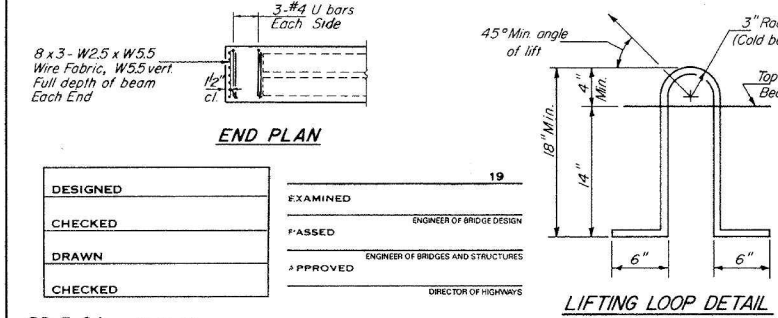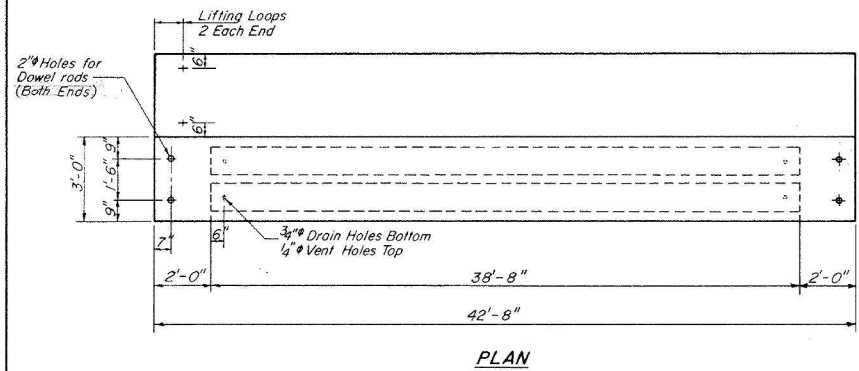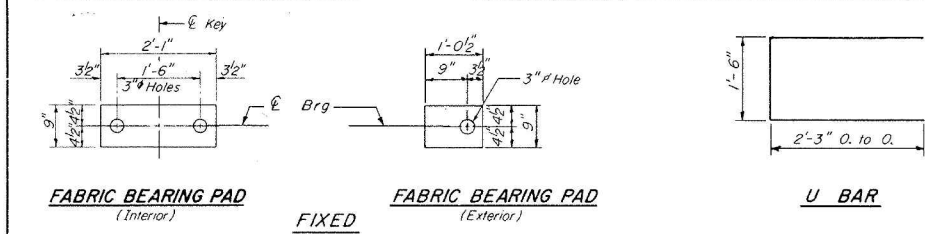

NOTES

Prestressing steel shall be non-galvanized high strength, stress-relieved 7-wire strand, Grade 270. The nominal diameter shall be 1/2" and the nominal cross-sectional area shall be 0.153 sq. in. Lifting loops shall be 1/2" diameter, 6 x 25 class wire rope with fiber core and shall have a minimum ultimate tensile strength of 21,000 lbs. Or 2-1/2" 270 ksi strands, as shown. Key surfaces shall be cleaned to remove form oil or other bond breaking material prior to shipment of the beams. Cleaning shall be done by sandblasting the keyway areas between top of the beam and the bottom edge of the key.

Reinforcement bars shall conform to AASHTO M-31 or M-53, Grade 60. The bearing seat surfaces shall be adjusted by shimming to assure firm and even bearing. Two 1/8" fabric adjusting shims of the dimensions of the Exterior Bearing Pad shall be provided for each bearing.

A Calcium Nitrite Corrosion Inhibitor, as covered in the Special Provisions, shall be used in the concrete for precast prestressed concrete deck beams. Required Release Strength, f'ci, shall be 4,000 p.s.i.

An equal substitution of the low-relaxation strands for the stress-relieved strands will be permitted.

BILL OF MATERIAL				
Bar	No.	Size	Length	Shape
B	32	#5	42'-4"	—
B1	32	#5	9'-0"	—
U	96	#4	6'-0"	□
Precast Prestressed Concrete Deck Beams			Sq Ft.	1024

DEPARTMENT OF TRANSPORTATION	
SUPERSTRUCTURE	
MFT SECTION 90-22108-00-BR	
STATION 20+00	
WILL TOWNSHIP, WILL COUNTY	
McDonough Associates Inc. Engineers/Architects	DESIGNED BY: RKT CHECKED BY: SMR DRAWN BY: RUO

JUN 22, 2013 1:15 PM SCH000827

DATE	SOURCE



SSA MASTER PLAN - FLOODPLAINS REPORT
APPENDIX D-4 (CONT.)
AS BUILT/ RECORD DRAWINGS FOR MONEE RESERVOIR

STATE OF ILLINOIS
DEPARTMENT OF TRANSPORTATION

ROUTE NO.	SECTION	COUNTY	TOTAL SHEETS	SHEET NO.
		WILL		4
FED. ROAD DIST. NO. 7		ILLINOIS	FED. AID PROJECT-	

SHEET NO.
SHEETS

Follow structural steel tubing shall conform to the requirements of ASTM designation A-500 Grade B Structural Steel Tubing.

All other steel shapes and plates shall conform to the requirements of AASHTO M-183 except posts and angles shall conform to AASHTO M-223, Grade 50.

Bolts, cap screws and nuts shall conform to the requirements of ASTM designation A-307 except for high strength bolts, nuts and washers noted which shall conform to AASHTO M-164.

All bolts, nuts, cap screws, washers and lock washers shall be galvanized in accordance with AASHTO M-232.

All posts, railing, rail splices, anchor devices and angles shall be galvanized after shop fabrication in accordance with AASHTO M-III and ASTM A-385. Galvanized rail shall not be painted.


Railing shall be in accordance with Section 508 of the Standard Specifications, except as noted, and will be paid for at the contract unit price per linear foot for STEEL RAILING, TYPE WT.

All field drilled holes shall be coated with an approved zinc rich paint before erection.

The $\frac{1}{2}$ " x 6" plates that come in contact with concrete shall receive two coats of asphalt paint conforming to Section 714.08 Type B or place $\frac{1}{8}$ " fabric bearing pads between the plates and concrete.



The $\frac{3}{4}$ " high strength bolts used to connect the 6" x 4" x $\frac{3}{4}$ " angles to the post shall be tightened in accordance with Article 507.04(g)(3) of the Standard Specifications. The 1" ϕ high strength bolts connecting the angles to the concrete shall be tightened to a snug fit and given an additional $\frac{1}{8}$ turn. The $\frac{3}{8}$ " ϕ cap screws in bottom of posts shall be tightened to a snug fit only.

For multi-span bridges, sufficient $\frac{1}{4}$ " x 6" x 1'-2" galvanized steel shims shall be provided to align rail between adjacent spans. Cost incidental to Steel Railing.


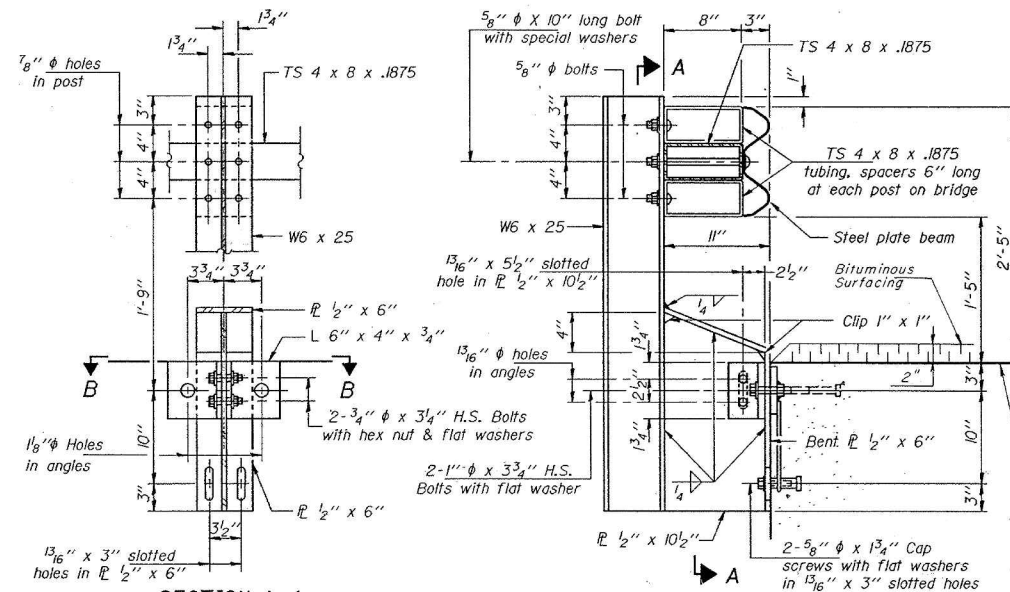


SECTION AT RAIL POST

Item	Unit	Quantity
Steel Railing, Type WT	Lin. Ft.	86

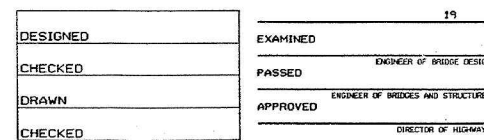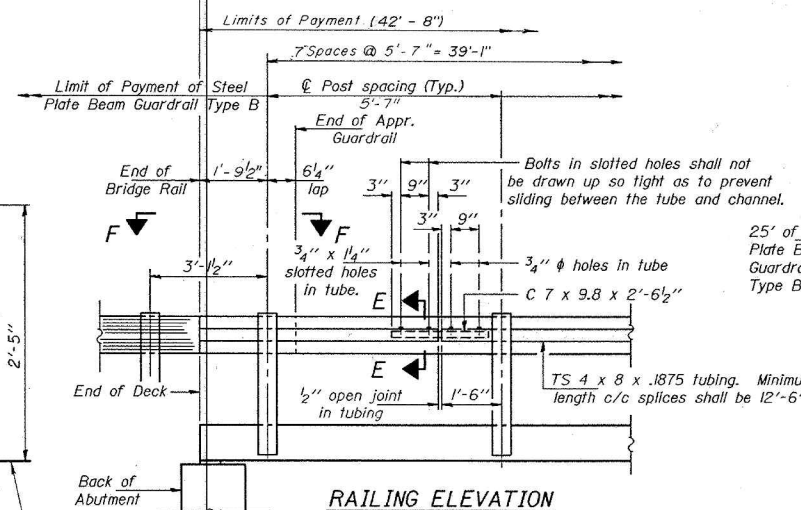
[illegible]

RAILING ELEVATION

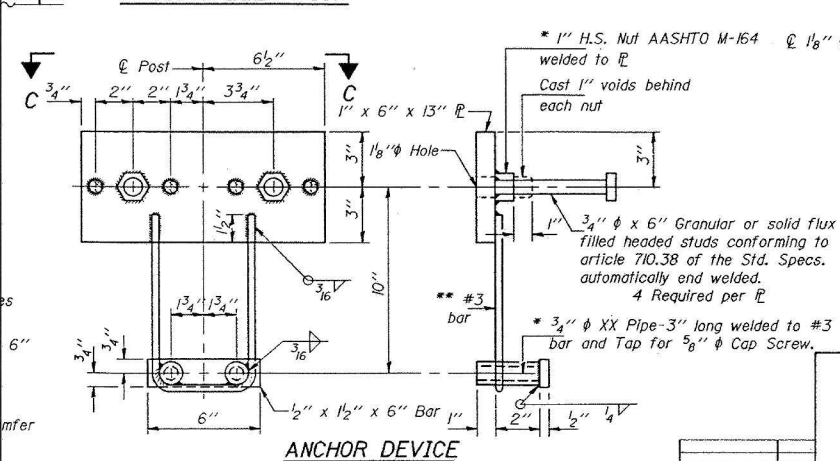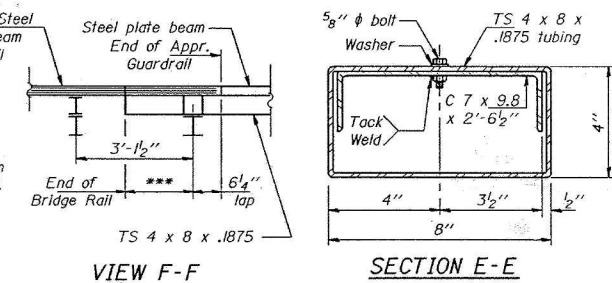

ANCHOR DEVICE

* Threaded areas shall be plugged or blocked off during casting of beam.

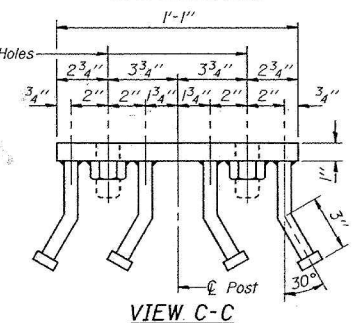

VIEW C-C

DEPARTMENT OF TRANSPORTATION
TYPE WT STEEL RAILING
MFT SECTION 90-22108-00-BR
STATION 20 + 00

WILL TOWNSHIP, WILL COUNTY



McDonough Associates Inc.
Engineers / Architects

DESIGNED BY:	
CHECKED BY:	*
DRAWN BY:	

* IDOT STANDARD DRAWING






Illinois Department of Transportation
Division of Aeronautics



SSA MASTER PLAN - FLOODPLAINS REPORT
APPENDIX D-4 (CONT.)
AS BUILT/ RECORD DRAWINGS FOR MONEE RESERVOIR

STRUCTURE R4 ON ROCK CREEK

ROUTE NO.	SECTION	COUNTY	TOTAL SHEETS	SHEET NO.
		WILL	8	5
PER. ROAD DIST. NO. 7 ILLINOIS PER. AID PROJECT				

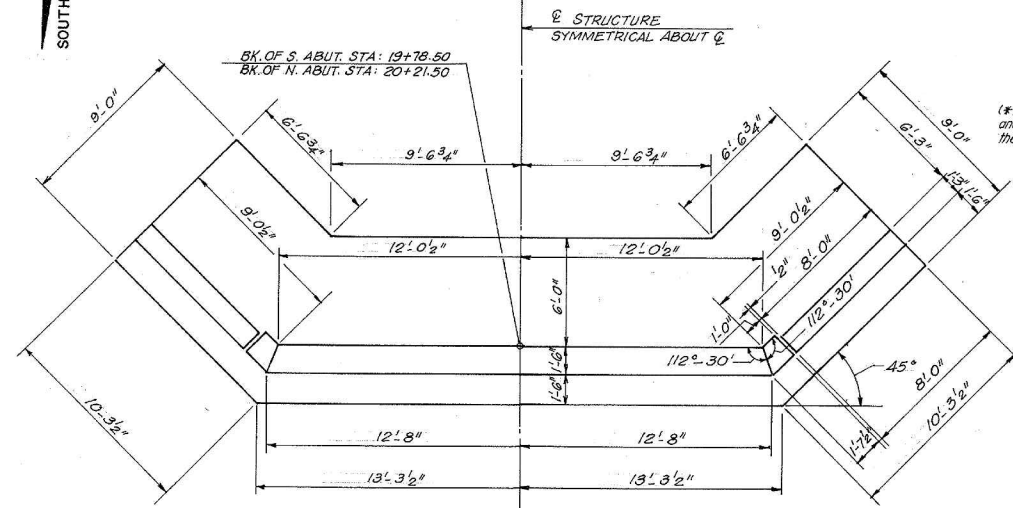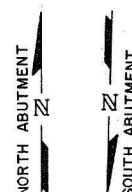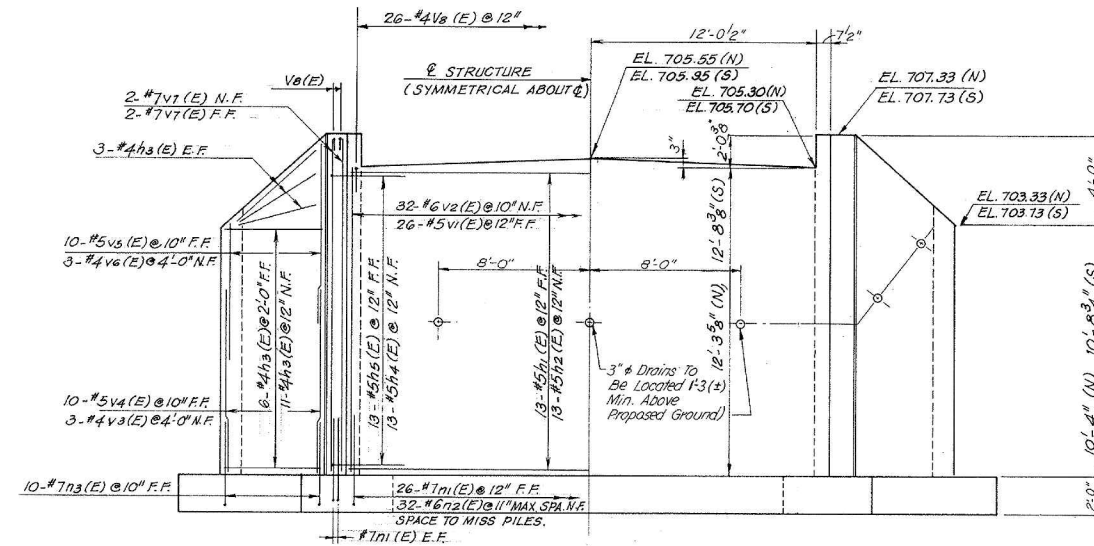

LEGEND:
 FF - FAR FACE
 NF - NEAR FACE
 EF - EACH FACE
 (N) - AT NORTH ABUTMENT
 (S) - AT SOUTH ABUTMENT


LAYOUT PLAN

ELEVATION


SHOWING REINFORCEMENT
 SHOWING DIMENSIONS
 PILES NOT SHOWN SEE SHT. NO. 6 FOR PILE LOCATION.

1/2\" Preformed Joint Filler (P.J.F.) Full Width
 3/4\" Chamfer (Typical)


BEAM BEARING DETAIL
 (*) Dowel Rods to be grouted after beams are in place and allowed to cure a min. 24 hours prior to grouting the shear keys.

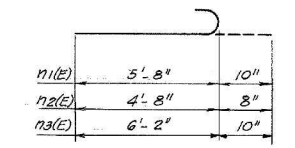

BARS n1(E), n2(E) & n3(E)

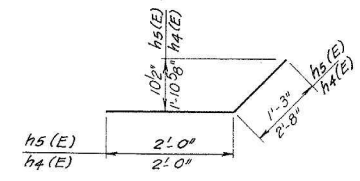

BARS h4(E) & h5(E)

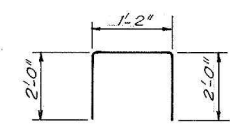

BAR v8(E)

BILL OF MATERIAL (FOR ONE ABUT.)

Bar	No.	Size	Length	Shape
n1(E)	13	#5	26'-6"	—
n2(E)	13	#5	25'-0"	—
n3(E)	46	#4	7'-8"	—
h4(E)	26	#5	4'-8"	—
h5(E)	26	#5	3'-3"	—
v1(E)	26	#5	12'-2"	—
v2(E)	32	#6	12'-2"	—
v3(E)	6	#4	8'-6"	—
v4(E)	20	#5	8'-6"	—
v5(E)	20	#5	7'-10"	—
v6(E)	6	#4	7'-6"	—
v7(E)	8	#7	14'-2"	—
v8(E)	30	#4	5'-2"	—
n1(E)	34	#7	6'-6"	—
n2(E)	32	#6	5'-4"	—
n3(E)	20	#7	7'-0"	—
t1	68	#5	8'-8"	—
t2	70	#6	8'-8"	—
w1	19	#5	26'-0"	—
w2	1	#5	23'-0"	—
w3	38	#5	10'-0"	—
w4	2	#5	8'-0"	—
CLASS X CONCRETE			CU. YDS	56.0
REINFORCEMENT BARS			LBS.	2480
REINFORCEMENT BARS (EPOXY COATED)			LBS.	3810
TEST PILE (HP10x42)			EACH	1
STEEL PILES (HP10x42)			LIN. FT.	851

REINFORCEMENT BARS DESIGNATED (E) SHALL BE EPOXY COATED.

NOTE:
 WORK THIS SHEET WITH SHEET NO. 6

DEPARTMENT OF TRANSPORTATION
 NORTH AND SOUTH ABUTMENTS
 MFT SECTION 90-22108-00-BR
 STATION 20+00
 WILL TOWNSHIP, WILL COUNTY

DESIGNED BY: B.K.
 CHECKED BY: R.U.D.
 DRAWN BY: A.T.

NO.	DATE	REVISION	BY




Illinois Department of Transportation
 Division of Aeronautics




SSA MASTER PLAN - FLOODPLAINS REPORT
 APPENDIX D-4 (CONT.)
 AS BUILT/ RECORD DRAWINGS FOR MONEE RESERVOIR

STRUCTURE R4 ON ROCK CREEK

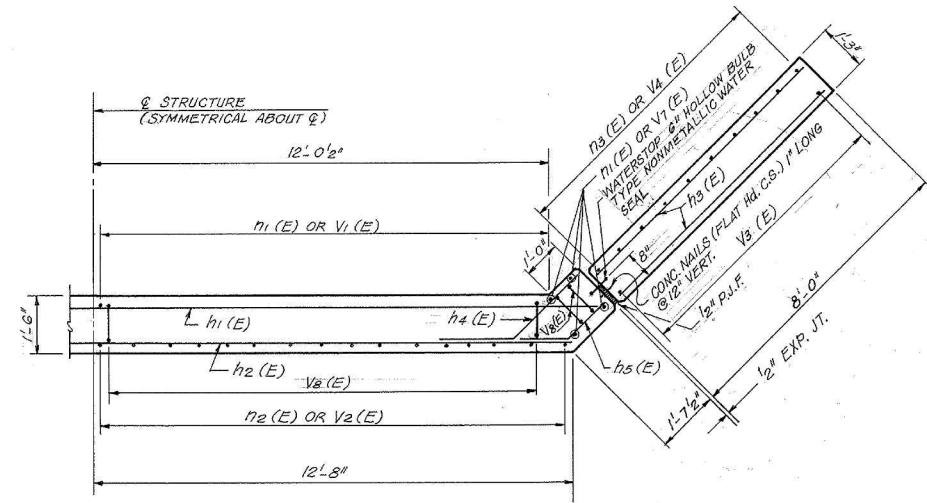


TOP PLAN

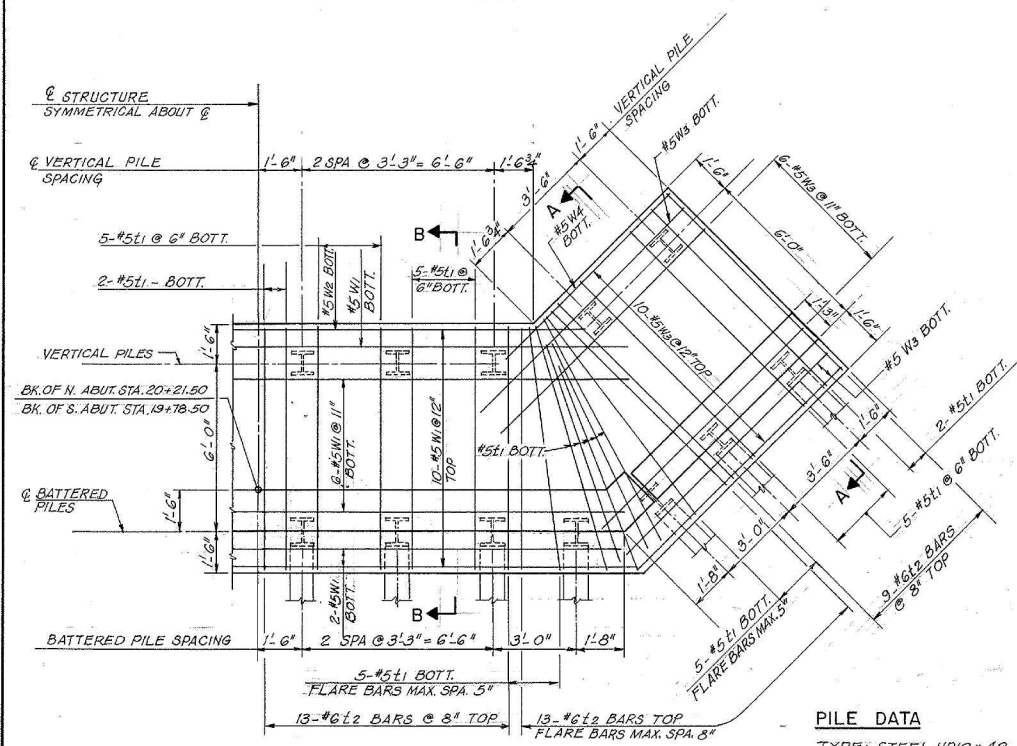


FOOTING PLAN

PILE DATA

TYPE: STEEL HP10x42
CAPACITY: REFUSAL
EST. LENGTH: 37 FT.
NO. REQD: 23 + 1 TEST PILE (PER ABUT.)

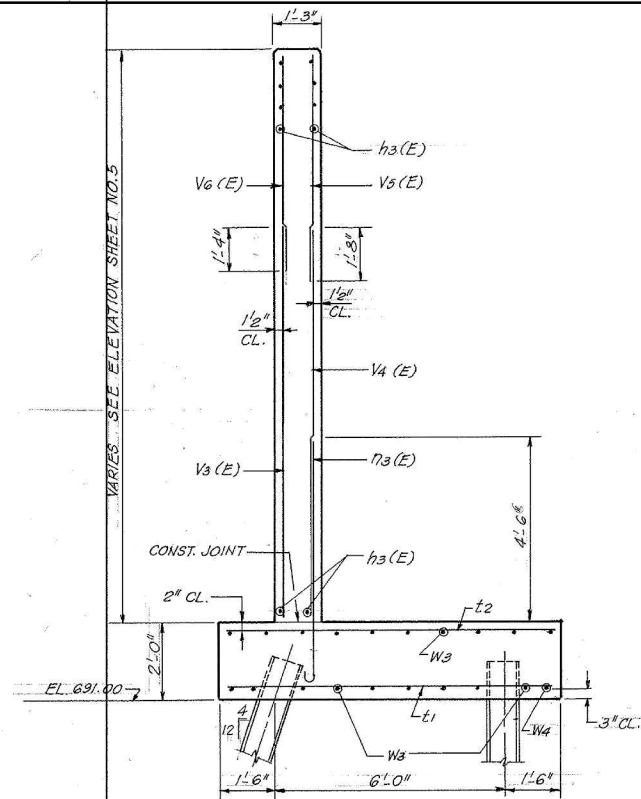


SECTION A-A

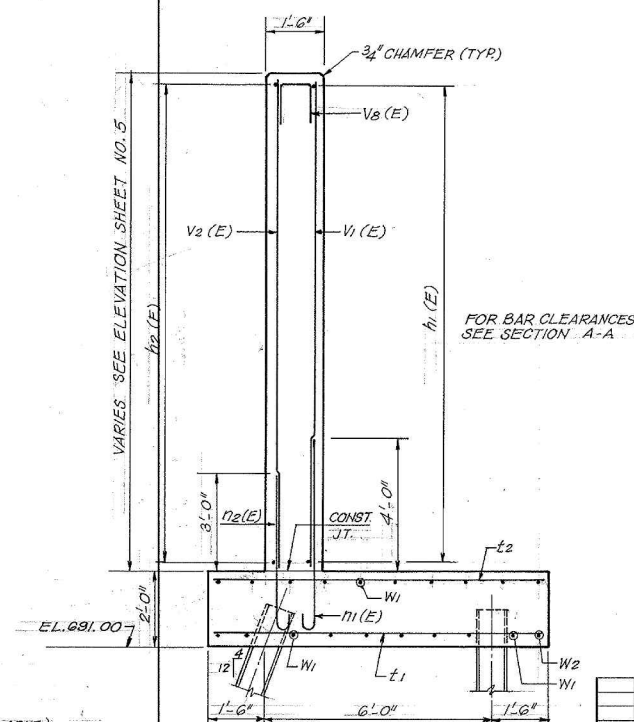

SECTION B-B

DEPARTMENT OF TRANSPORTATION
NORTH AND SOUTH ABUTMENTS

 MFT SECTION 90- 22108- 00-BR
STATION 20+00
WILL TOWNSHIP, WILL COUNTY

DESIGNED	B.K.	 McDonough Associates Inc. Engineers / Architects			SHEET NO.
DRAWN	R.U.Q.				
CHECKED	A.T.	PROJECT NUMBER	SCALE	DATE	6
APPROVED		90051	NONE	4-26-91	
OF SHEETS					

McDonough Associates Inc.
Engineers / Architects

PROJECT NUMBER 90051
SCALE NONE
DATE 4-26-91

SHEET NO.
6
OF SHEETS




Illinois Department of Transportation
Division of Aeronautics




SSA MASTER PLAN - FLOODPLAINS REPORT
APPENDIX D-4 (CONT.)
AS BUILT/ RECORD DRAWINGS FOR MONEE RESERVOIR

STRUCTURE R5 ON ROCK CREEK

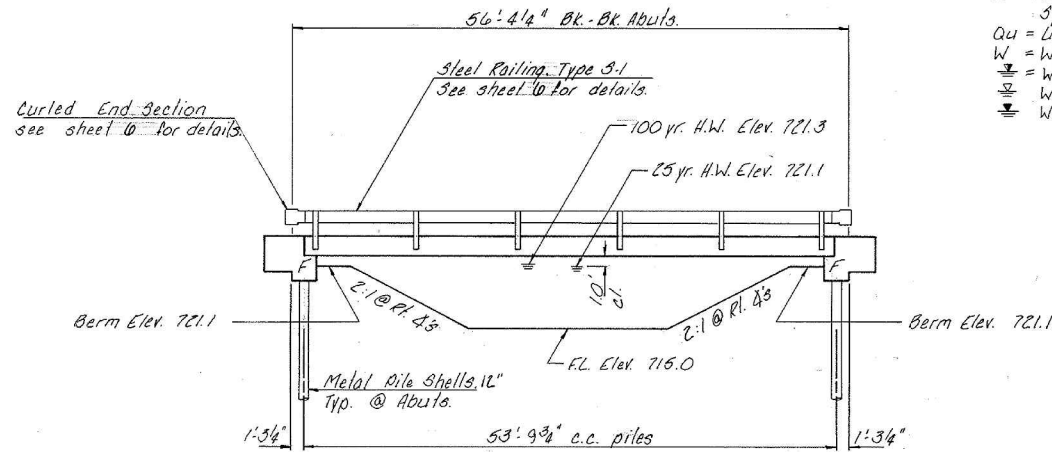

ELEVATION

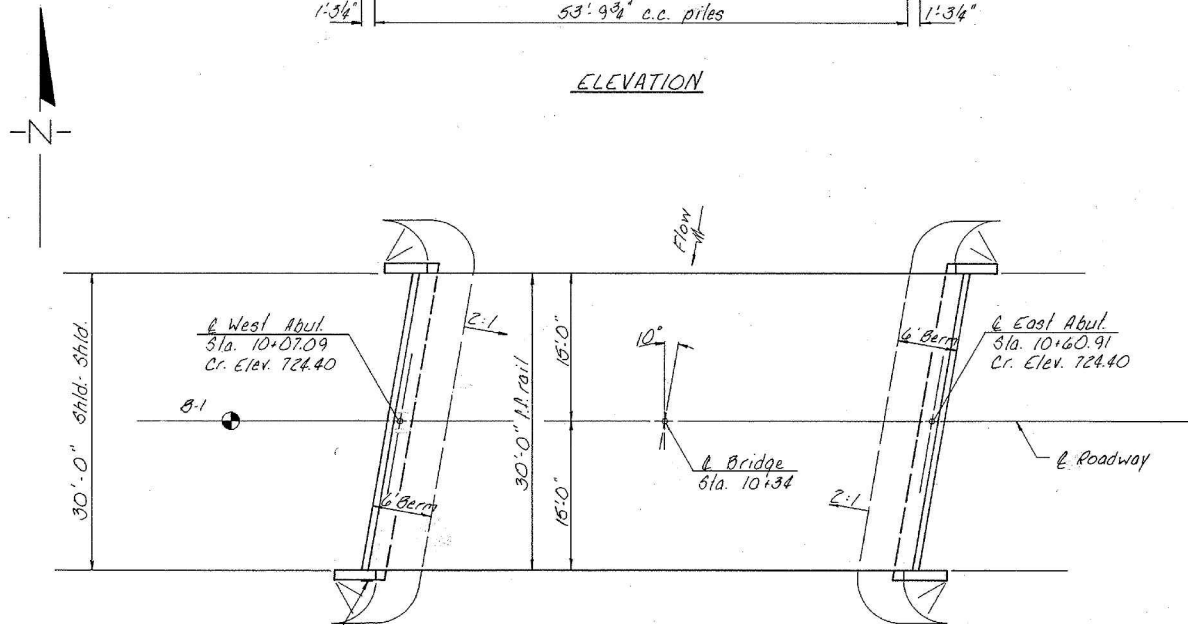

PLAN

GENERAL NOTES

The contractor shall drive one test pile in a permanent location at the East Abutment, as directed by the Engineer, before ordering the remainder of the piles.

WATERWAY DATA

Drainage Area _____ 5.33 Sq. Mi.
Existing Opening _____ N.A.
Required Opening (25 yr.) _____ 185 Sq. Ft.
Proposed Opening (25 yr.) _____ 185 Sq. Ft.
Design Discharge (25 yr.) _____ 650 C.F.S.
Created Head (25 yr.) _____ 0.4 Ft.
100 yr. Discharge _____ 880 C.F.S.
100 yr. Created Head _____ 0.7 Ft.

DESIGN STRESSES

f'_c = 5,000 psi (Prestressed Beams)
 f_{ci} = 4,800 psi (Prestressed Beams)
 f_c = 1,400 psi (Class X Concrete)
 f'_s = 270,000 psi (Prestressed Strands)
 f_{si} = 189,000 psi (Prestressed Strands)
 f_s = 20,000 psi (Rein. Bars - Field Units)
 f_y = 60,000 psi (Rein. Bars - Precast Units)
 n = 9 (Class X Concrete)
Loading: HS 20-44
Design Specifications: AASHTO 1977 & 1978-82 Interims.
25% 139 Ft. included in dead load for future wearing surface.


BORING DATA

N = Standard Penetration Test - Blows per foot to drive 2" O.D. Split Spoon Sampler 12" with 140# hammer falling 30"
Qu = Unconfined Compressive Strength - Tons (Sq. Ft.)
W = Water Content - percentage of oven dry weight - %
= Water Elev. while drilling
= Water Elev. after completion
= Water Elev. after 24 hours

STRUCTURE NO. 099-4654
ROCK CREEK
SEC. 82-13112-00-BR BUILT 198-
MONEE ROAD DISTRICT
WILL COUNTY
LOADING HS20

LETTERING FOR NAME PLATE

See Sld. 2113

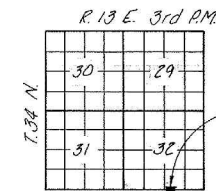

LOCATION PLAN

N	Qu	W	
720	18	238	Fill - Black clay loam, moist
715	23	3.91	209
	7	1.95	237
	6	1.55	280
710	13	0.98	164
	15	-	168
705	28	2.65	139
	23	2.47	132
700	26	2.44	185
	31	2.26	186
695	37	3.29	276
	30	-	-
690	44	-	-
	40	-	-
685	48	-	-
	50	-	-
680	75	-	-
	20	-	-
675	28	-	-

BORING NO. 1

@ Sta. 9+90

TOTAL BILL OF MATERIAL

ITEM	UNIT	SUPER	SUB	TOTAL
Precast Prestressed Concrete Deck Beams (21" Depth)	Sq. Ft.	1,650		1,650
Class X Concrete	Cu. Yd.		17.9	17.9
Reinforcement Bars	Pound		2,170	2,170
Steel Railing, Type 3-1	Lin. Ft.	107		107
Metal Pile Shells, 12"	Lin. Ft.		188	188
Test Pile Metal Shell	Each		1	1
Name Plates	Each		1	1
Bit. Conc. Surf. Crse., Class I	Ton	10		10
Leveling Binder (Machine Method)	Ton	0		0

I certify that to the best of my knowledge, information, and belief, that this bridge design is structurally adequate for the design loading shown on the plans. The design is an economical one for the style of structure and complies with requirements of the current "AASHTO Standard Specifications for Highway Bridges".

Frank J. Stone Jr.
Illinois Structural No. 2934



GENERAL PLAN & ELEVATION
SECTION 82-13112-00-BR
MONEE ROAD DISTRICT
WILL COUNTY
STATION 10+34

COLLINS AND RICE
CONSULTING ENGINEERS

DESIGNED R.N.
DRAWN R.N.

CHECKED R.N.
DATE 4-18-82 NO. 1780



Illinois Department of Transportation
Division of Aeronautics



SSA MASTER PLAN - FLOODPLAINS REPORT
APPENDIX D-4 (CONT.)
AS BUILT/ RECORD DRAWINGS FOR MONEE RESERVOIR

30'-0" f-f rail

15'-0"

3/4" Drop in 15'-0"

Grouted Key
See Special Provisions

1/2" Bit Conc. Surf. Cge. Class I
with Leveling Binder as required

1/4" ft.

1/2" ft.

Int. Org. Pad
Ext. Org. Pad

10 Beams @ 3'-0" = 30'-0"

See sheet 10 for
Complete Rail Details.

Rdwy. & Symm.

3-#4 bars U
Each Side
Each End

3/4" Drain Holes, Bottom
4" Vent Holes, Top

8x8-W25xW55
Wire Fabric, W55 vert.
Full depth of beam
Each End

10"

1 1/2"

6" Typ.

2'-7"

24'-6"

5"

1'-4 3/8"

24'-6"

55'-0"

3" Hole for Tie Rods
Place Parallel to
Skew. See Detail

9" Typ.

12 1/2" O.D. Tubes

Lifting Loops
2 Each End

1'-0"

9"

1'-6"

9"

3'-0"

2" Holes for
Dowel Rods.
Each End

1'-10 1/2" 5 Spaces @ 10'-3" = 51'-3" 1'-10 1/2"

See sheet 4 for Rail Post Insert Details.

3 3/4" Typ

8'-10 1/2"

ELEVATION OF OUTSIDE BEAMS

13 1/2" Typ

The drawing shows a side view of a beam-to-column connection. The beam is on the left, and the column is on the right. The beam has a total width of 2'-1" and a depth of 1'-0". It contains two 3" diameter holes, with a center-to-center distance of 3 1/2". The column has a width of 1'-0 1/2" and a depth of 9". It contains one 3" diameter hole. The connection is shown in two views: INTERIOR (left) and EXTERIOR (right). The interior view shows the beam's end with a 3" hole and the column's side with a 3" hole. The exterior view shows the beam's side with a 3" hole and the column's end with a 3" hole. Dimensions are given in feet and inches.

INTERIOR
(18 Req'd.)

EXTERIOR
(4 Req'd.)

A diagram of a rectangle with a vertical dimension of 1' 6" and a horizontal dimension of 2' 2".

Technical drawing of a three-panel window assembly. The drawing shows a cross-section of the window frame and panels. Key components and dimensions are labeled:

- 4" x 4" x 1/8" min. Beveled Plate Washer**: Located at the top of the assembly, with a note "2 Required".
- Full thread sleeve 3" long**: A sleeve connecting the panels, with a note "9 Required".
- 3" Opening**: The gap between the panels.
- 1" x 3'-0" Rods (Thread Each End 4")**: Rods passing through the panels, with a note "10 Required".
- Nut for 1" x Rod**: A nut at the bottom of the rod, with a note "2 Required".
- Dimensions**:
 - Overall height: 9"
 - Panel height: 16"
 - Panel width: 16"
 - Panel thickness: 1/2"
 - Panel depth: 3"

Prestressing steel shall be non-galvanized high strength, stress-relieved 7-wire strand, Grade 270.

The nominal diameter shall be $\frac{1}{2}$ " and the nominal cross-sectional area shall be 0.153 sq. in.

Lifting Loops shall be 7-wire stress relieved, 2- $\frac{1}{8}$ " - 270 ksi strands.

The 1" rods in the transverse tie assembly shall be tightened to a snug fit & the threads set. Pockets that receive tie rods on outside shall be filled with grout after ties are in place.

Reinforcement bars shall conform to AASHTO: M-31 or M-53, Grade 60.

The bearing seat surfaces shall be adjusted by shimming to assure firm and even bearing. Two $\frac{1}{2}$ " fabric adjusting shims of the dimensions of the Exterior Bearing Pad shall be provided for each bearing.

A Calcium Nitrate Corrosion Inhibitor or covered in the Special Provisions shall be used in the concrete for precast prestressed concrete deck beams.

Diagram illustrating the repair of a bridge using fabric bridge pads and dowel rods.

Labels and dimensions shown in the diagram:

- $1\frac{1}{2} \times 2\frac{1}{2}$ " Prem. Jt. Filler (full width of bridge)
- $8"$ @ RT. 4.
- $9"$ H.P.
- $1\frac{1}{2}$ " Fabric Brg. Pad
- $3\frac{3}{4} \times 1'-0"$ Dowel Rods

Text description of the repair process:

After beams are in place drill holes in cap & grout dowel rods in place.
 Rods to be grouted prior to grouting the shear keys.

Technical drawing of a rectangular concrete beam cross-section with two circular voids. The drawing includes dimensions for overall size, void placement, and reinforcement details.

Dimensions:

- Overall width: 36"
- Overall height: 27"
- Top flange width: 10 1/4"
- Top flange thickness: 4"
- Web width: 15 1/2"
- Bottom flange width: 10 1/4"
- Bottom flange thickness: 3 1/4"
- Void diameter: 12 1/2" Dia.
- Void spacing: 12"
- Reinforcement spacing: 11" cl.
- Reinforcement spacing: 13" cl.
- Reinforcement spacing: 13 1/2" cl.
- Reinforcement spacing: 2 1/4" Typ.

Reinforcement Details:

- 4-#5 bars Full length of beam
- 2-#5 bars 11'-0" long Each End
- 2 3-strands
- 7 Strands
- 8 Strands
- 3/4" Chamfer (Typ.)

Other Notes:

- 8x3-W2.5xW5.5 Wire Fabric Full length of beam except at U bars. (W2.5 long.)

17- $\frac{1}{2}$ " ϕ Strands Stressed to 28,900 Lbs. Each.
Place strands symmetrically about ϕ of beam.
Use Standard Grid Pattern.

45° min. angle of lift.

3" Radius (Cold Bent)

Top of Beam

4" min.

14"

6"

NOTE: The loop should be lifted in a manner that the strands conform to the requirements of AASHTO M 203. Loops should be off after erected.

Strands shall conform to the requirements of AASHTO M 203

Approved alternate may be substituted for the above.

ITEM	UNIT	QUANTITY
Precast Prestressed Concrete Deck Beams (21" Depth)	Sq. Ft.	1,650
Bit. Conc. Surf. Cree. Class I	Ton	10
Leveling Binder (Machine Method)	Ton	0

ITEM	UNIT	QUANTITY
Precast Prestressed Concrete Deck Beams (21" Depth)	Sq. Ft.	1,650
Bit. Conc. Surf. Cree. Class I	Ton	10
Leveling Binder (Machine Method)	Ton	0


COLLINS AND RICE
CONSULTING ENGINEERS

CHECKED R. N.
DATE 4-18-81

NO. 1780

STRUCTURE R5 ON ROCK CREEK

ROUTE NO.	SECTION	COUNTY	TOTAL SHEETS	SHEET NO.
111A	82-1312-00-BR	WILL	8	0
FED. ROAD DIST. NO. 7 ILLINOIS PROJECT				

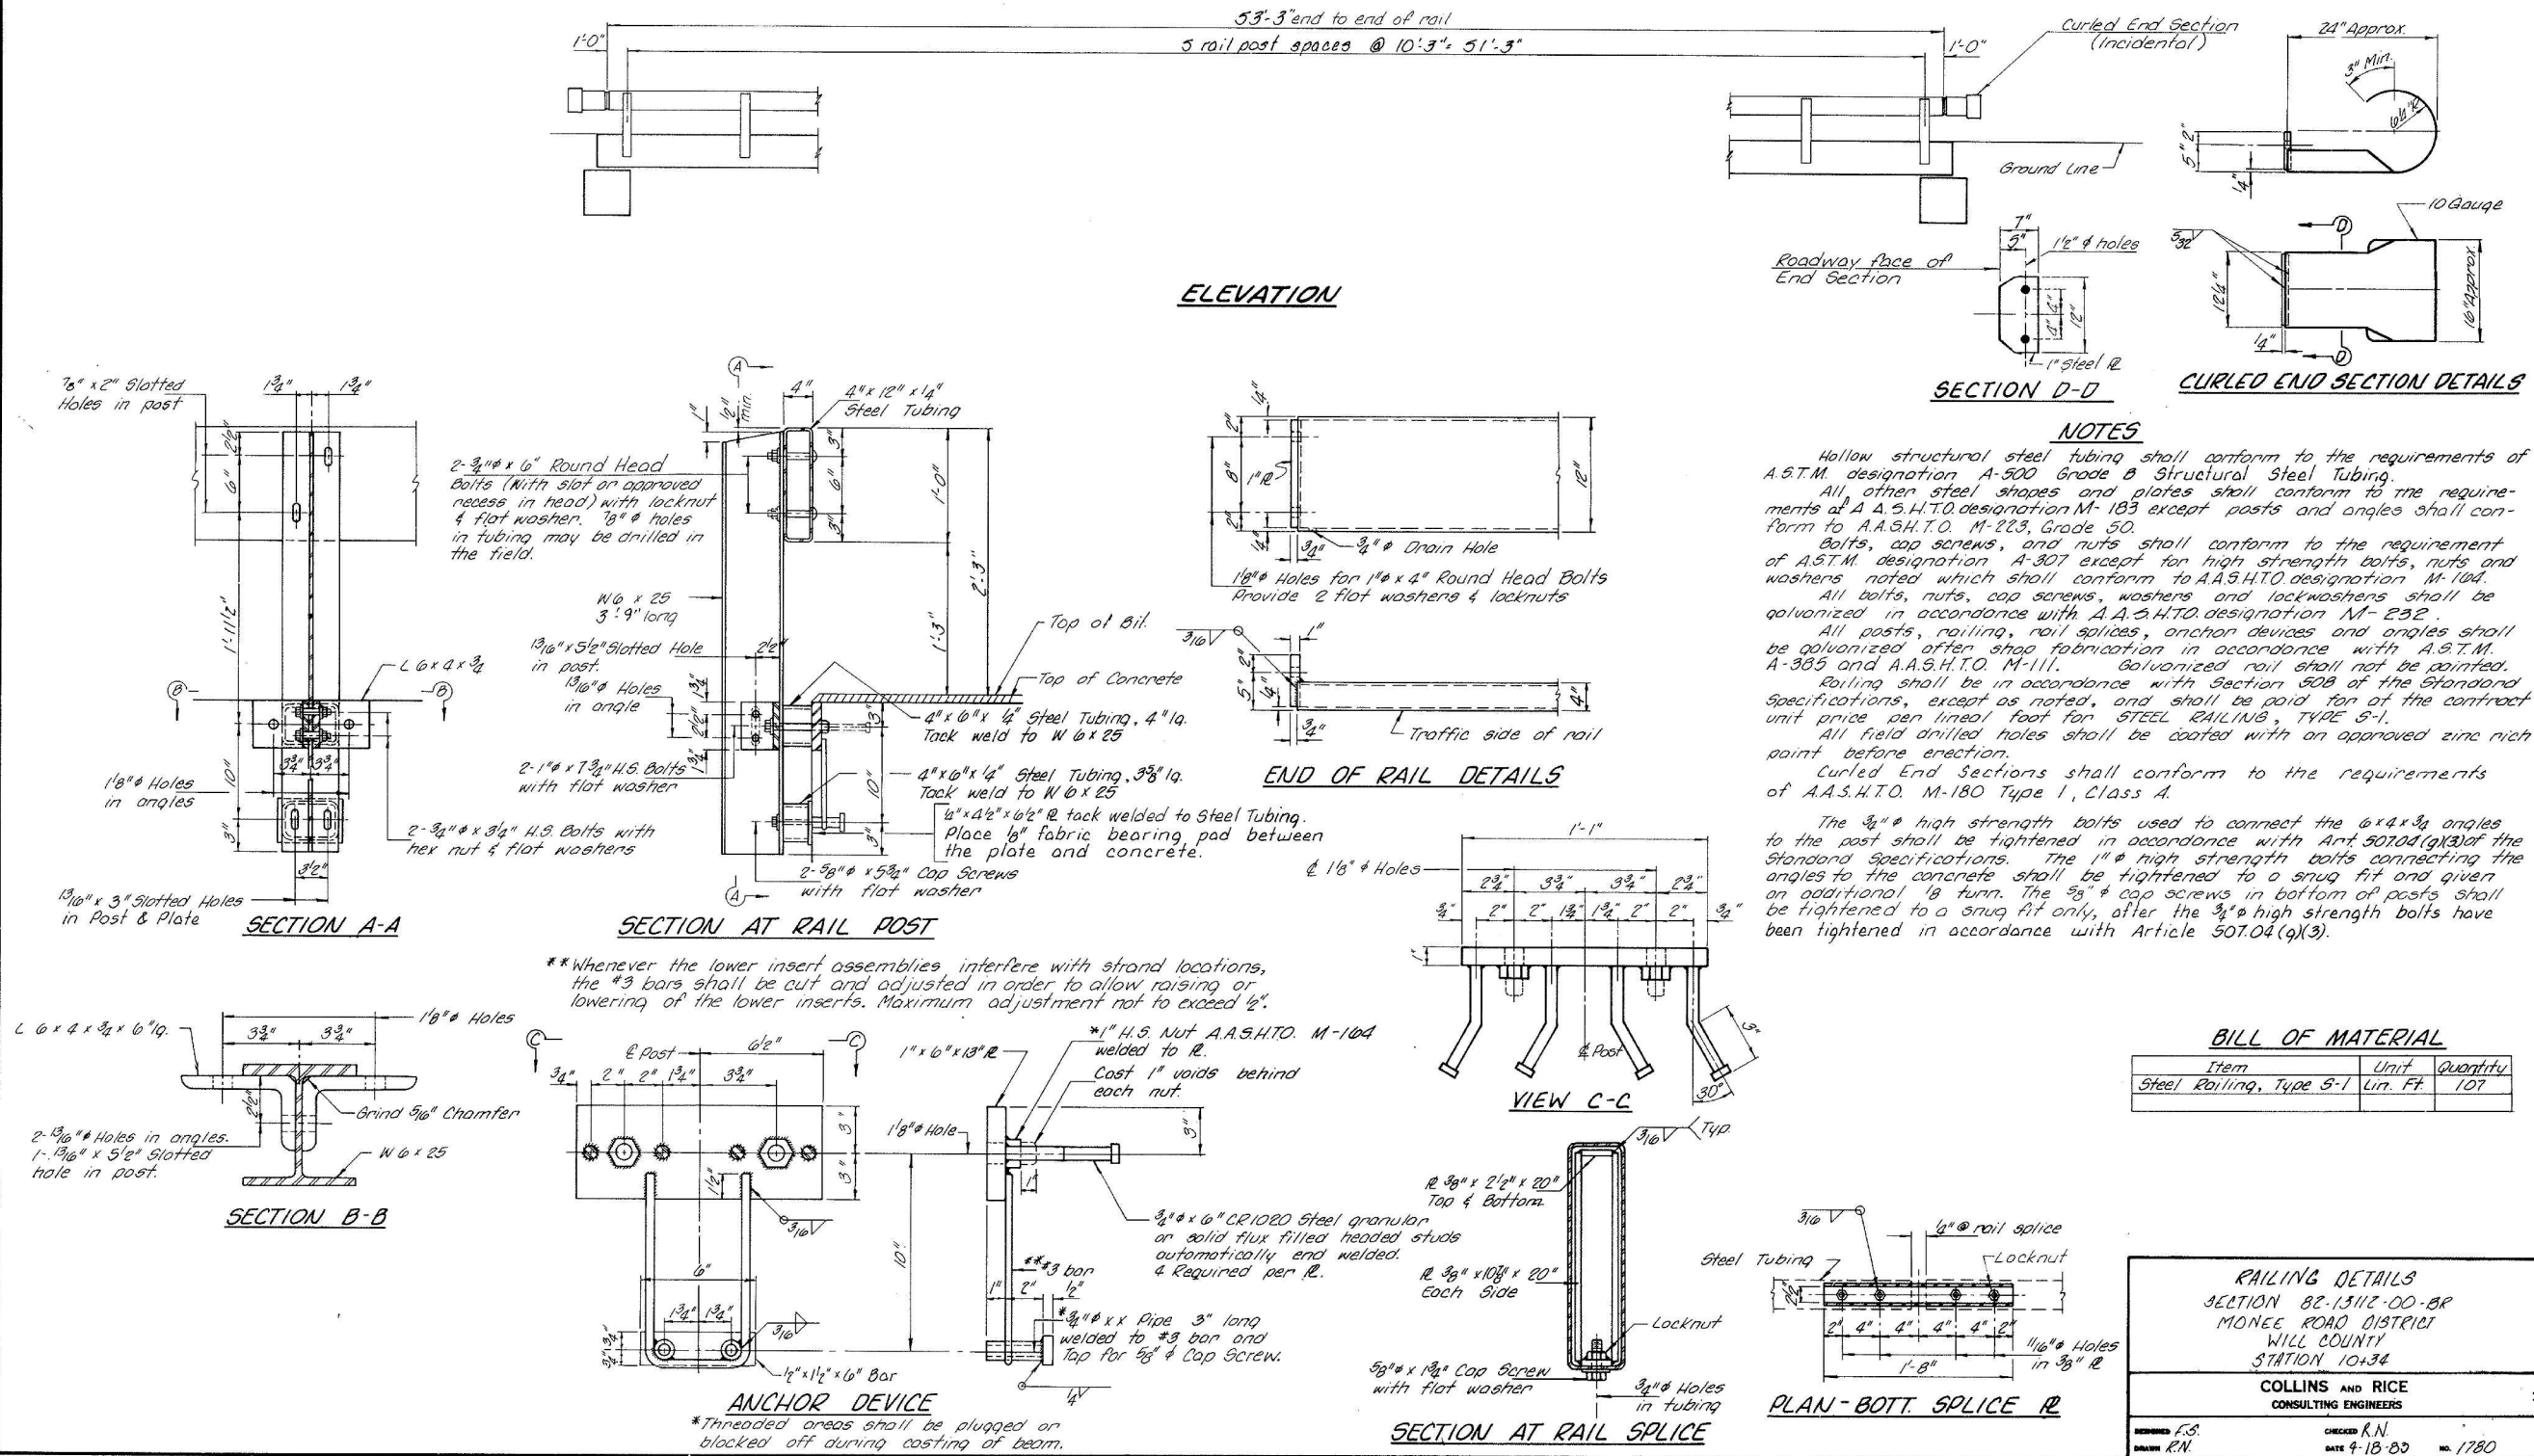


DATE	SOURCE



SSA MASTER PLAN - FLOODPLAINS REPORT
APPENDIX D-4 (CONT.)
AS BUILT/ RECORD DRAWINGS FOR MONEE RESERVOIR



ROUTE NO.	SECTION	COUNTY	TOTAL SHEETS	SHEET NO.
I.R. 277A	82-13112. 00-BR	WILL	8	7
FED. ROAD DIST. NO. 7		ILLINOIS PROJECT		

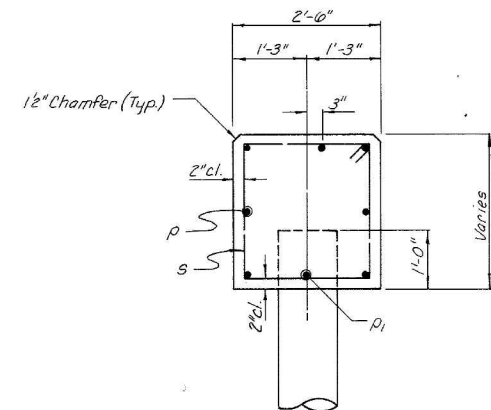

Technical drawing of a mechanical part. The part has a horizontal base of 5'-0" and a vertical height of 2'-100". The top surface is inclined at an angle of 2'-138". The top edge is 2'-8" wide. The drawing is a side view showing the profile of the part.



Diagram of a stepped profile with dimensions: 2'-2".00, 5/8", and 2'-2".00.

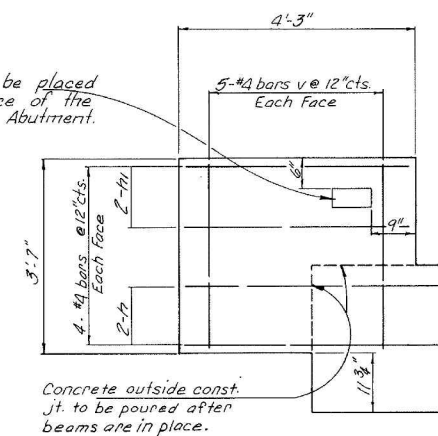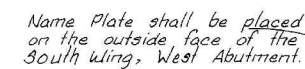PLAN

PILE DATA

Type _____ Metal Pile Shells 12"
No. Req'd. (2 Abuts.) _____ 10*
Capacity _____ 36 Tons/Pile
Est. Length _____ 32 Feet/Pile

* Includes one test pile to be driven in a permanent location at the East Abutment

BAR	NO.	SIZE	LENGTH	SHAPE
h	16	#4	4'-11"	—
p	16	#4	4'-0"	—
p	14	#7	32'-6"	—
p	6	#7	5'-10"	—
s	68	#5	9'-7"	
u	16	#6	12'-1"	
v	40	#4	3'-4"	—

Class X Concrete	Cu. Yd.	179
Reinforcement Bars	Pound	2,170
Name Plates	Each	1
Metal Pile Shells, 12"	Lin. Ft.	288
Test Pile Metal Shell	Each	1

See Sheet 8 for Pile Details

Class X Concrete	Cu. Yd.	179
Reinforcement Bars	Pound	2,170
Name Plates	Each	1
Metal Pile Shells, 12"	Lin. Ft.	288
Test Pile Metal Shell	Each	1

ABUTMENTS
SECTION 82-13112-00-BR
MONEE ROAD DISTRICT
WILL COUNTY
STATION 10+34



COLLINS AND RICE
CONSULTING ENGINEERS

DESIGNED *F.S.*
DRAWN *R.N.*

CHECKED *R.N.*
DATE *4-18-83* NO *1780*

STRUCTURE R5 ON ROCK CREEK

ROUTE NO.	SECTION	COUNTY	TOTAL SHEETS	SHEET NO.
CR 511A	82-1312-00-08	WILL	8	8
FED. ROAD DIST. NO. 7 ILLINOIS PROJECT				

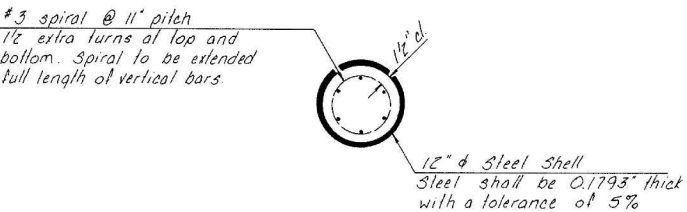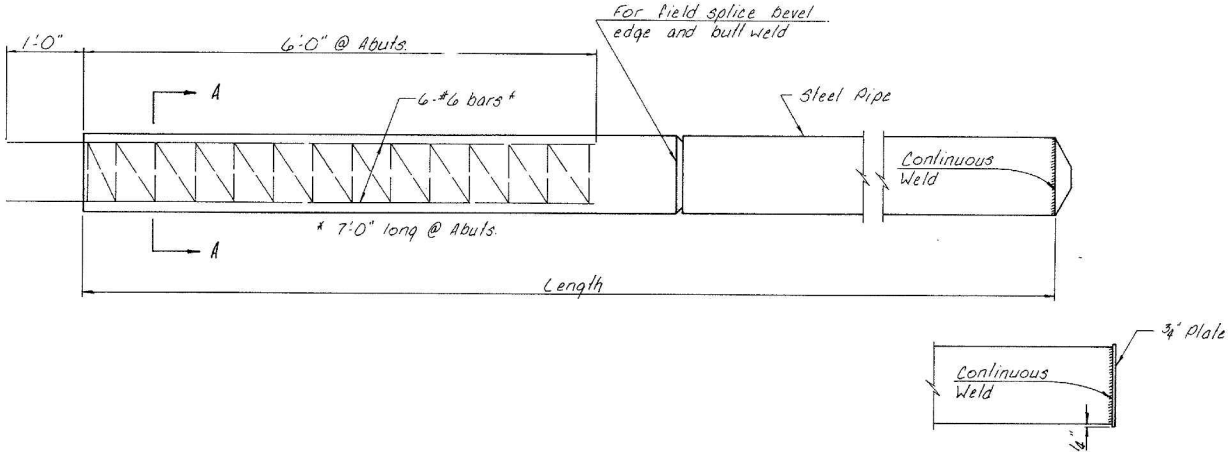

SECTION A-A
Note: Cost of reinforcement in piling is incidental to the cost of driving piles.

DETAIL OF CAST IN PLACE CONCRETE PILES

PILE DETAILS SECTION 82-1312-00-08 MONEE ROAD DISTRICT WILL COUNTY STATION 10+34	
COLLINS AND RICE CONSULTING ENGINEERS	
DESIGNED F.S. DRAWN R.N.	CHECKED R.N. DATE 4-18-80 NO. 1780

JUN 22 2013 1:34 PM SCHIED0827

DATE	SOURCE



SSA MASTER PLAN - FLOODPLAINS REPORT
APPENDIX D-4 (CONT.)
AS BUILT/ RECORD DRAWINGS FOR MONEE RESERVOIR

STRUCTURE R28 ON ROCK CREEK


STATION 1028+00
BUILT 195 BY
STATE OF ILLINOIS
S.B.I. RT 49 SEC. 142 3R
LOADING H2O-SIG

DETAIL OF NAME PLATE
See Std #2113

GENERAL NOTES

Bridge Contractor must move in two lanes of traffic while removing Existing Structure one half at a time and constructing proposed Culverts one half at a time as shown in plans. See Special Provisions for Steel sheet Piling.

Temporary Timber Members presently supporting abutments shall be stock piled for Maintenance Dept. pick up. Cost to be incidental.

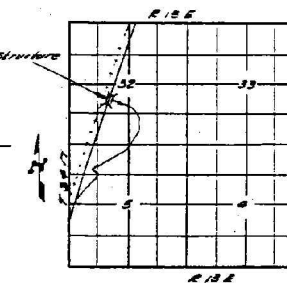

TOTAL BILL OF MATERIAL

ITEM	TOTAL
CURB & CONCRETE	Cu Yds. 317.2
Reinforcement Bars	Lbs. 39,570
Removal of Exist. Structure	Each 1
Name Plates	Each 1
Steel Sheet Piling	Sq. Ft. 1120

GENERAL PLAN ELEVATION
S.B.I. RT. 49-SECT. 142 B & P
WILL COUNTY
STATION 1028+00

VERTICAL CURVE DATA
(See plan & profile)

WATERWAY INFORMATION

Drainage Area	3200 Acres
Channel	Rolling, wooded, cultivated
Reg'd Opening (35 yr. Flood)	280'
Pipe and Opening	216 Sq. Ft.
Proposed opening	220 Sq. Ft.

DESIGN STRESSES

fc	—	—	—	20,000 p.s.i. (Paint)
fc	—	—	—	1000 p.s.i. (Barrel)
fc	—	—	—	1000 p.s.i. (Wings)
n	—	—	—	10


LOADING HZO-516-44

DESIGN: <i>H. S. Monahan</i>	EXAMINED: <i>[Signature]</i>	19 <i>5</i>
CHECK: <i>M. G. Lelan</i>	PASSED: <i>[Signature]</i>	CHARGE: <i>TRAFFIC AND TRAFFIC STOPPAGE</i>
DRAWN: <i>H. S. M. ENG-4204</i>	APPROVE: <i>[Signature]</i>	FORWARD OF CHARGE: <i>[Signature]</i>
CHECK: <i>M. G. Lelan</i>		

Revised 4/22/67 for Consts H. G. & Edw. J. Neal Wiring added
 Revised 8/11/67 for Consts H. G. & Edw. J. Neal Wiring added
 Revised 10/1/67 for 12" Consts

MONEE RESERVOIR

OUTLET STRUCTURE IMPROVEMENTS

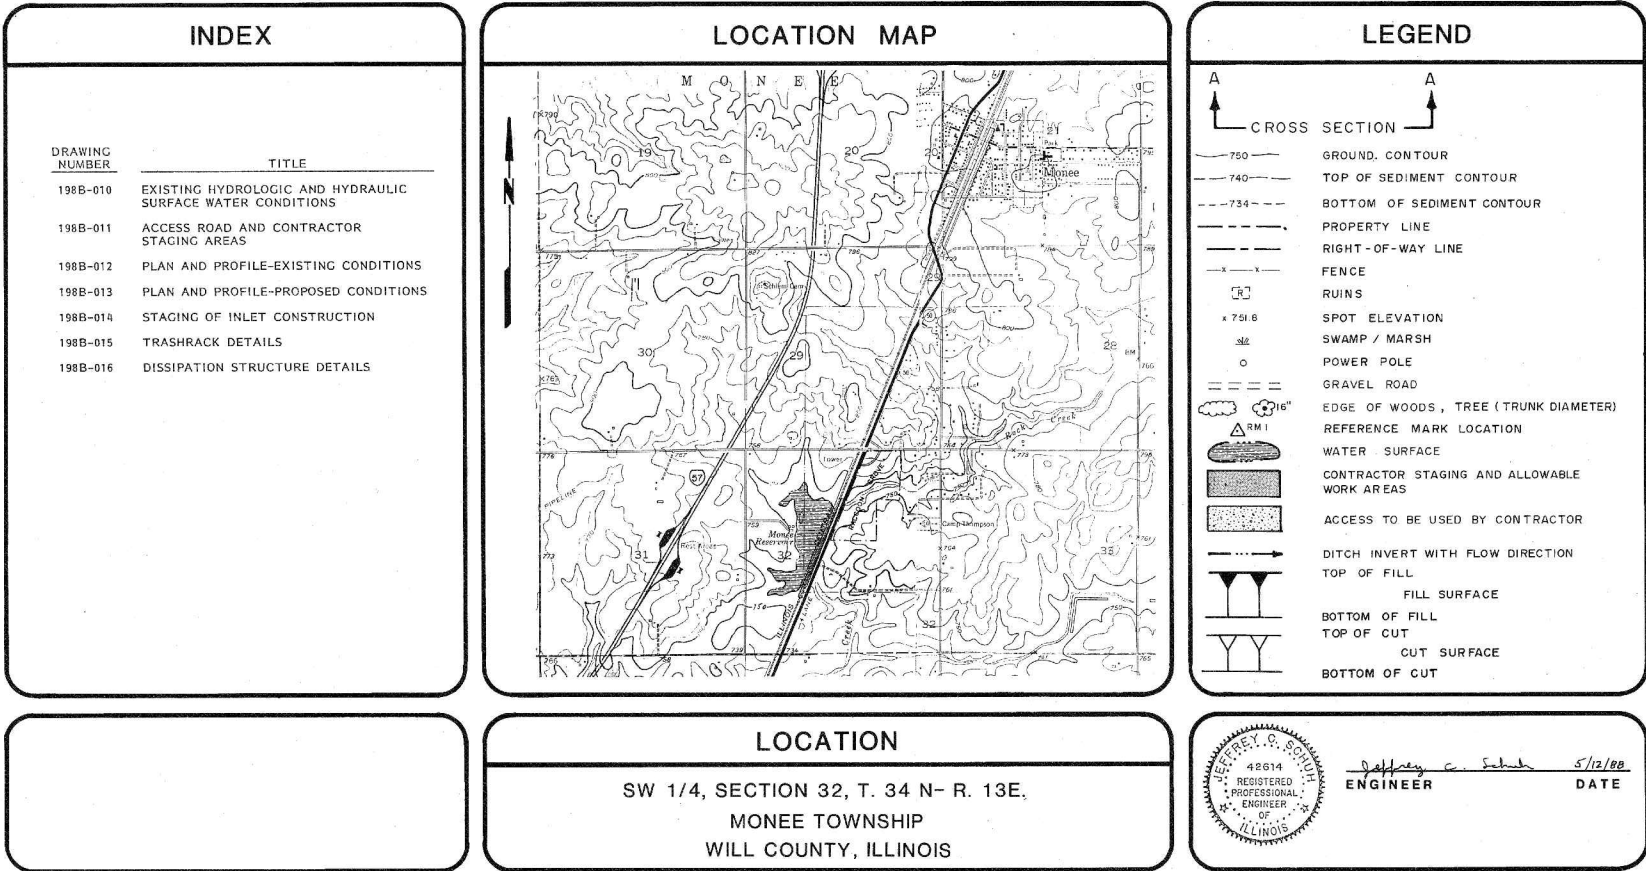

"AS BUILTS"
2/24/89


SITE OWNER :
THE FOREST PRESERVE
DISTRICT OF WILL COUNTY
CHERRY HILL RD. & RT. 52 R.R. 4
JOLIET, ILLINOIS 60433

PREPARED BY:
PATRICK ENGINEERING INC.
346 TAFT AVENUE
GLEN ELLYN, ILLINOIS 60137

JUN 22, 2013 1:37 PM SCHUCH0827


DATE	SOURCE



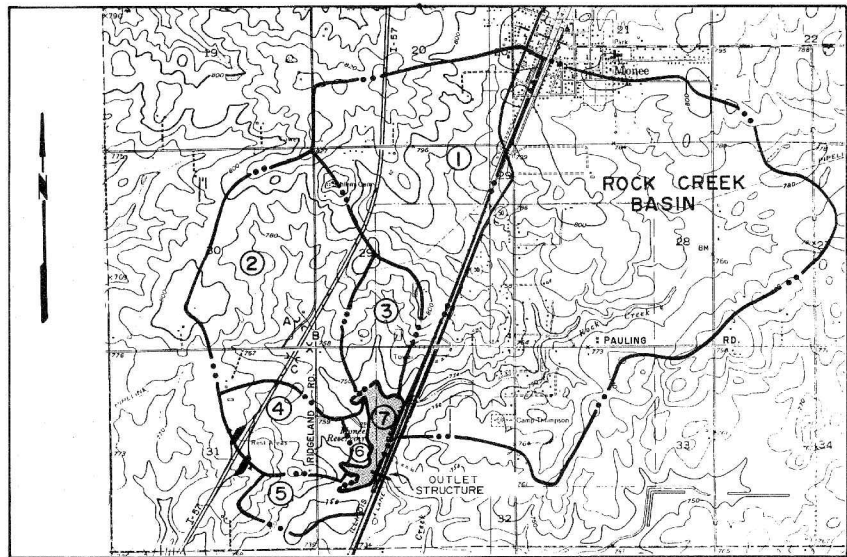

MAP OF DRAINAGE AREAS

Scale 0 2000 Feet

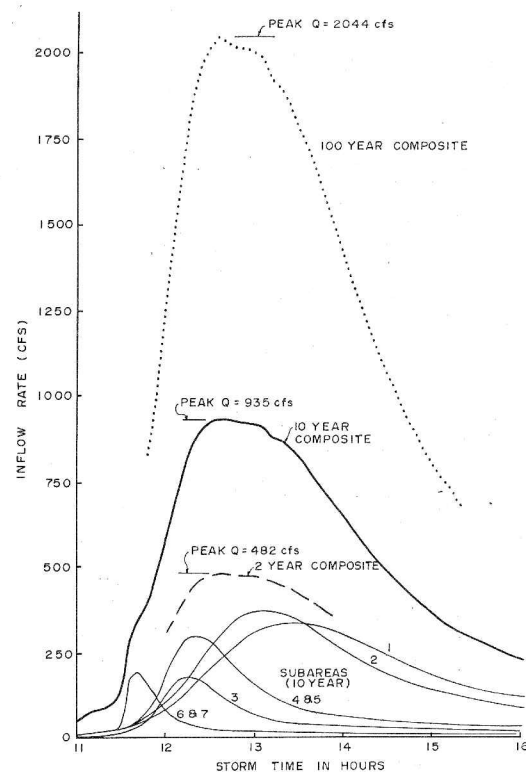


INFLOW HYDROGRAPHS AT RESERVOIR


SUB-BASIN CHARACTERISTICS		
SUB-BASIN	RUNOFF CURVE NUMBER	DRAINAGE AREA (ac)
1	85	543.5
2	85	498.8
3	84	126.7
4	86	145.1
5	85	79.5
6	75	18.3
7	100	43.1
TOTAL		1,455.0

CULVERT TABLE


- A TWIN 3'H X 6'W CONCRETE BOX CULVERT
 B 5'H X 8'W CONCRETE BOX CULVERT
 C 24" DIA. CONCRETE PIPE

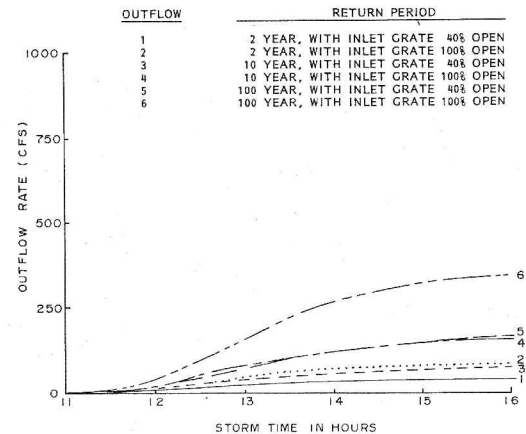


OUTFLOW HYDROGRAPHS AT RESERVOIR OUTLET

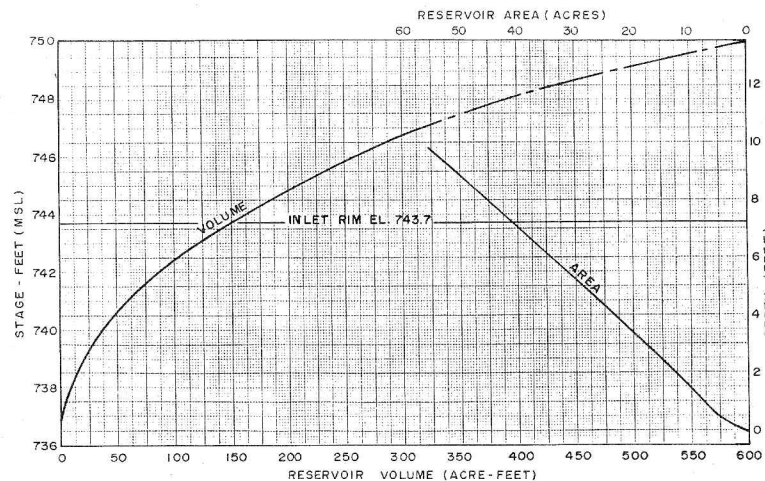

STAGE-AREA-VOLUME RELATIONSHIP

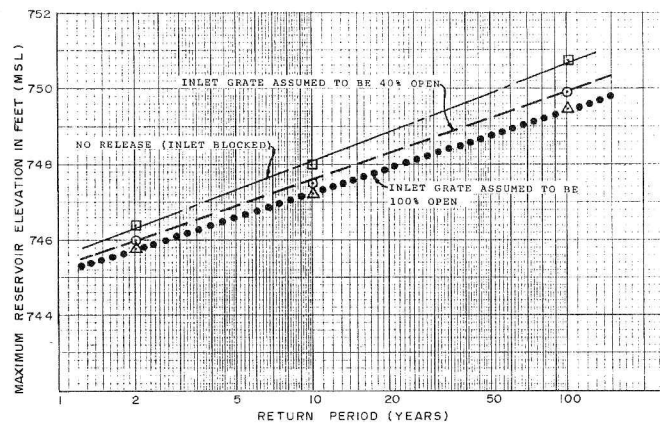

MAXIMUM RESERVOIR ELEVATION VS. RETURN PERIOD FOR ORIFICE AND WEIR CONTROL AT THE OUTLET STRUCTURE

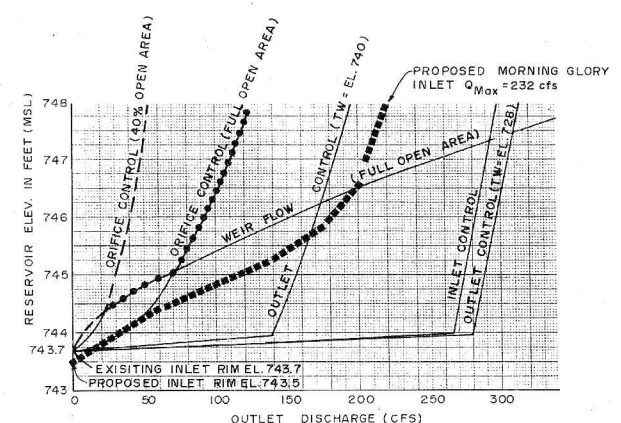


OUTFLOW RATES FROM RESERVOIR OUTLET

NOTES

- DRAINAGE AREAS WERE DETERMINED WITH THE AID OF THE U.S.G.S. 7.5 MINUTE TOPOGRAPHICAL MAPS OF FRANKFORD, ILL., 1953, PHOTOREVISED 1973 AND STEGER, ILL., 1953, PHOTOREVISED 1973. ALSO UTILIZED WAS AN AERIAL TOPOGRAPHIC SURVEY, RACCOON GROVE, SHEET 2 OF 2, SCALE 1" = 100', CONTOUR INTERVAL = 2', DATED 11-21-77, BY AIR MAPS, INC., ELKHART, INDIANA. A SITE RECONNAISSANCE WAS MADE ON NOVEMBER 23, 1984, BY A PATRICK ENGINEERING ENGINEER.
- SOIL TYPES WITHIN THE DRAINAGE BASINS WERE DETERMINED WITH THE AID OF THE WILL COUNTY SOIL MANUAL, PREPARED BY THE WILL COUNTY REGIONAL PLANNING DEPARTMENT, JUNE 1975.
- GROUND COVER WAS DETERMINED ON THE BASIS OF OBSERVED CONDITIONS DURING FIELD RECONNAISSANCE IN NOVEMBER 1984.
- INFLOW AND OUTFLOW HYDROGRAPHS WERE DETERMINED ON THE BASIS OF STORMS WITH 2, 10 AND 100 YEAR FREQUENCIES, 24 HOUR DURATION (REF. TECHNICAL LETTER 13, RAINFALL FREQUENCIES, ILLINOIS STATE WATER SURVEY, DECEMBER 1970), AND A SOIL CONSERVATION SERVICE (S.C.S.) TYPE II RAINFALL DISTRIBUTION. A COMPUTERIZED VERSION OF THE S.C.S. TR-55 PROCEDURES FOR CONVERTING RAINFALL TO RUNOFF WAS UTILIZED IN THE ANALYSIS.
- TIME OF CONCENTRATION WERE BASED ON S.C.S. NEH-4 NOMOGRAPH VALUES WHICH WERE DETERMINED BY SCALING THE GROUND SLOPE AND DISTANCE AND GROUND COVER CONDITIONS FROM PREVIOUSLY REFERENCED MAPS.
- THE OUTLET STRUCTURE WAS FIELD SURVEYED IN NOVEMBER 1984. THE TRASHRACK AND OUTLET CAP WERE PARTIALLY BLOCKED WITH DEBRIS.
- A COMPUTERIZED VERSION OF THE STORAGE - INDICATION WORKING CURVE (MODIFIED PULS) METHOD OF RESERVOIR ROUTING WAS UTILIZED TO ESTIMATE THE WATER LEVEL IN THE RESERVOIR AS A FUNCTION OF THE INFLOW. THIS PROCEDURE ASSUMES THAT THE DISCHARGE FROM THE BASIN IS A FUNCTION OF THE STAGE - STORAGE CHARACTERISTICS OF THE BASIN AND ASSUMES A CONSTANT TAILWATER ELEVATION.
- WATER SURFACE ELEVATIONS IN THE RESERVOIR ARE INDEPENDENT OF THE TAILWATER IN ROCK CREEK AND DEPEND UPON THE EFFICIENCY OF THE INLET ENTRANCE.
- POSSIBLE SEEPAGE LOSS FROM THE RESERVOIR THROUGH THE RAILROAD EMBANKMENT WAS NOT CONSIDERED. NO SEEPAGE LOSS THROUGH THE RESERVOIR BOTTOM SEDIMENTS WAS ASSUMED.
- FOR CONSTRUCTION OF THE SPILLWAY IMPROVEMENTS, THE INLET GRATE SHOULD BE CONSIDERED TO BE BLOCKED FOR INLET IMPROVEMENTS AND 100% OPEN FOR OUTLET IMPROVEMENTS. OUTLET IMPROVEMENTS MUST CONSIDER THE DISCHARGE FROM THE MORNING GLORY INLET IF IN PLACE. THE DISCHARGE FROM THE PROPOSED MORNING GLORY INLET IS SHOWN IN THE ABOVE GRAPH.

△ DRAWING REPRESENTS THE HYDROLOGIC CONDITIONS PRIOR TO CONSTRUCTION.

REV.	DATE	DESCRIPTION	DR BY	APP BY
1	2/24/89	'AS BUILT' INFORMATION ADDED	RML	J.C.S.
SCALE:	AS SHOWN	JOB NO. 1988	CLIENT: Forest Preserve District of Will Co.	
DATE:	MAY, 1988	PROJECT: MONEE RESERVOIR-RACCOON GROVE WILL COUNTY, ILLINOIS		
DES BY:	KMB	SHEET TITLE:	EXISTING	
DR BY:	WRM	HYDROLOGIC & HYDRAULIC		
CHK BY:	DPD	SURFACE WATER CONDITIONS		
APP BY:	DPD			
PATRICK ENGINEERING INC.			SHEET OF	
Geotechnical/Environmental Engineers			DRAWING NO.	
Glen Ellyn, Illinois			198D-010	

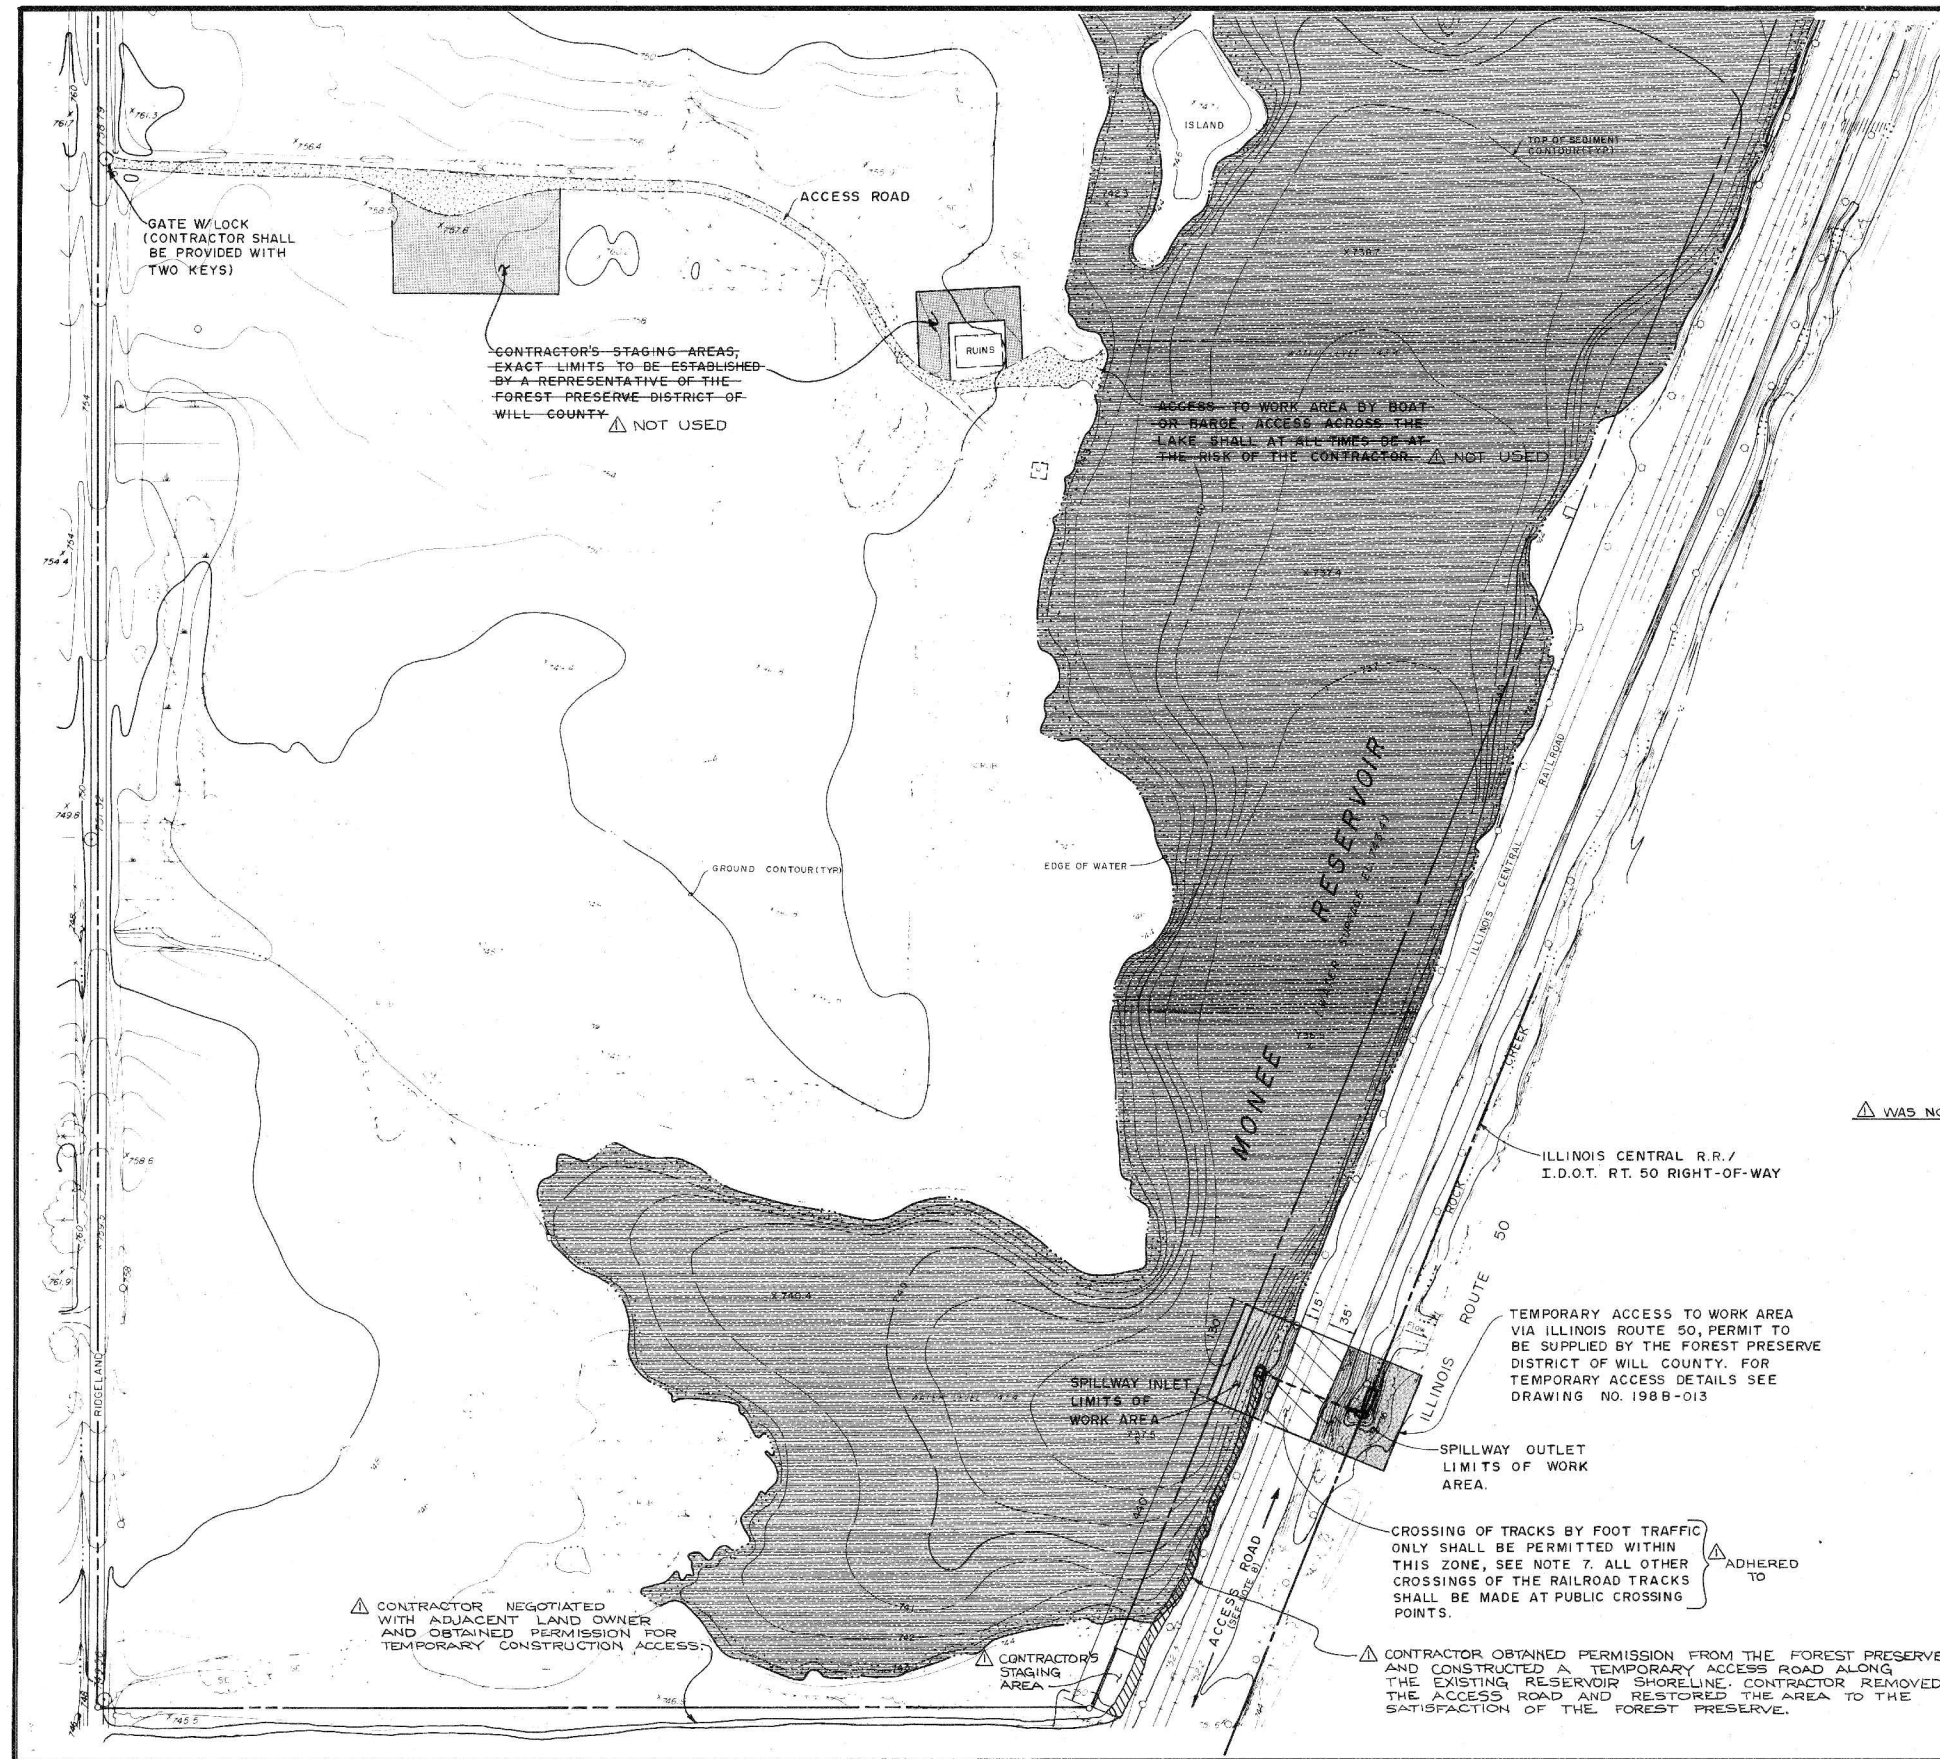

NOTES:

1. FIELD SURVEY OF LAKE BOTTOM TOPOGRAPHY WAS PERFORMED BY PATRICK ENGINEERING INC. IN NOVEMBER 1988 BY TAKING DEPTH PROBES AT MAXIMUM 200 FOOT INTERVALS FROM A ROW BOAT. ELECTRONIC DISTANCE MEASURING EQUIPMENT (EDM TOTAL STATION) WAS USED FOR HORIZONTAL CONTROL.
2. LAND SURFACE TOPOGRAPHY ABOVE LAKE WATER LEVEL COMPILED BY PHOTOGRAMMETRIC METHODS BY AIR MAPS, INC., ELKHART, INDIANA ON NOVEMBER 21, 1977.
3. BENCHMARK USED IS A CHISELED CROSS ON TOP OF THE HEADWALL WHERE THE HEADWALL ABUTS THE SOUTH WINGWALL FOR A TWIN CONCRETE BOX CULVERT ON ROCK CREEK ON THE UPSTREAM SIDE OF IL ROUTE 50 ACROSS FROM THE RESERVOIR OUTLET STRUCTURE, REPORTED EL. 736.08 N.G.V.D.
4. PROPERTY LINES TAKEN FROM PLAT OF SURVEY BY GEOTECH INC., DATED JULY 7, 1982, REVISED NOVEMBER 29, 1982.
5. NO WORK SHALL BE PERFORMED WITHIN 15 FEET OF THE RAILROAD TRACKS.
6. THE CONTRACTOR IS RESPONSIBLE FOR MAINTENANCE OF THE ACCESS ROADS DURING CONSTRUCTION.
7. A REPRESENTATIVE OF THE ILLINOIS CENTRAL RAILROAD SHALL BE PRESENT AT ALL TIMES DURING CONSTRUCTION. THE RESPONSIBILITY OF THE CONTRACTOR, THE RAILROAD WILL REQUIRE CERTIFICATES OF INSURANCE FROM THE CONTRACTOR.
8. THE ACCESS ROAD SHALL NOT BE USED BY THE CONTRACTOR WITHOUT WRITTEN AUTHORIZATION BY THE ILLINOIS CENTRAL RAILROAD.
9. TRAIN TRAFFIC SHALL NOT BE SLOWED OR DELAYED BY THE CONTRACTOR'S ACTIVITIES.
10. STAGING AREA TO BE RESTORED BY CONTRACTOR TO PRECONSTRUCTION CONDITIONS.

△ WAS NOT PRESENT AT ANY

SCALE 0 100 200 FEET
1" = 100'


2/24/88 "AS BUILT" INFORMATION		RML	JCS
REV.	DATE	DESCRIPTION	DR BY APP BY
SCALE:	AS SHOWN	PROJECT:	
DATE:	MAY, 1988	MONEE RESERVOIR OUTLET STRUCTURE IMPROVEMENTS	
DES BY:	JCS	SHEET TITLE:	
DR BY:	HB	ACCESS ROAD AND CONTRACTOR STAGING AREAS	
CHK BY:	JCS		
APP BY:	DPD		
PATRICK ENGINEERING INC. Geotechnical/Environmental Engineers Glen Ellyn, Illinois		SHEET _____ OF _____ DRAWING NO. 198D-011	

JUN 22, 2013 1:40 PM SCHIED0827

DATE	SOURCE



SSA MASTER PLAN - FLOODPLAINS REPORT
APPENDIX D-4 (CONT.)
AS BUILT/ RECORD DRAWINGS FOR MONEE RESERVOIR

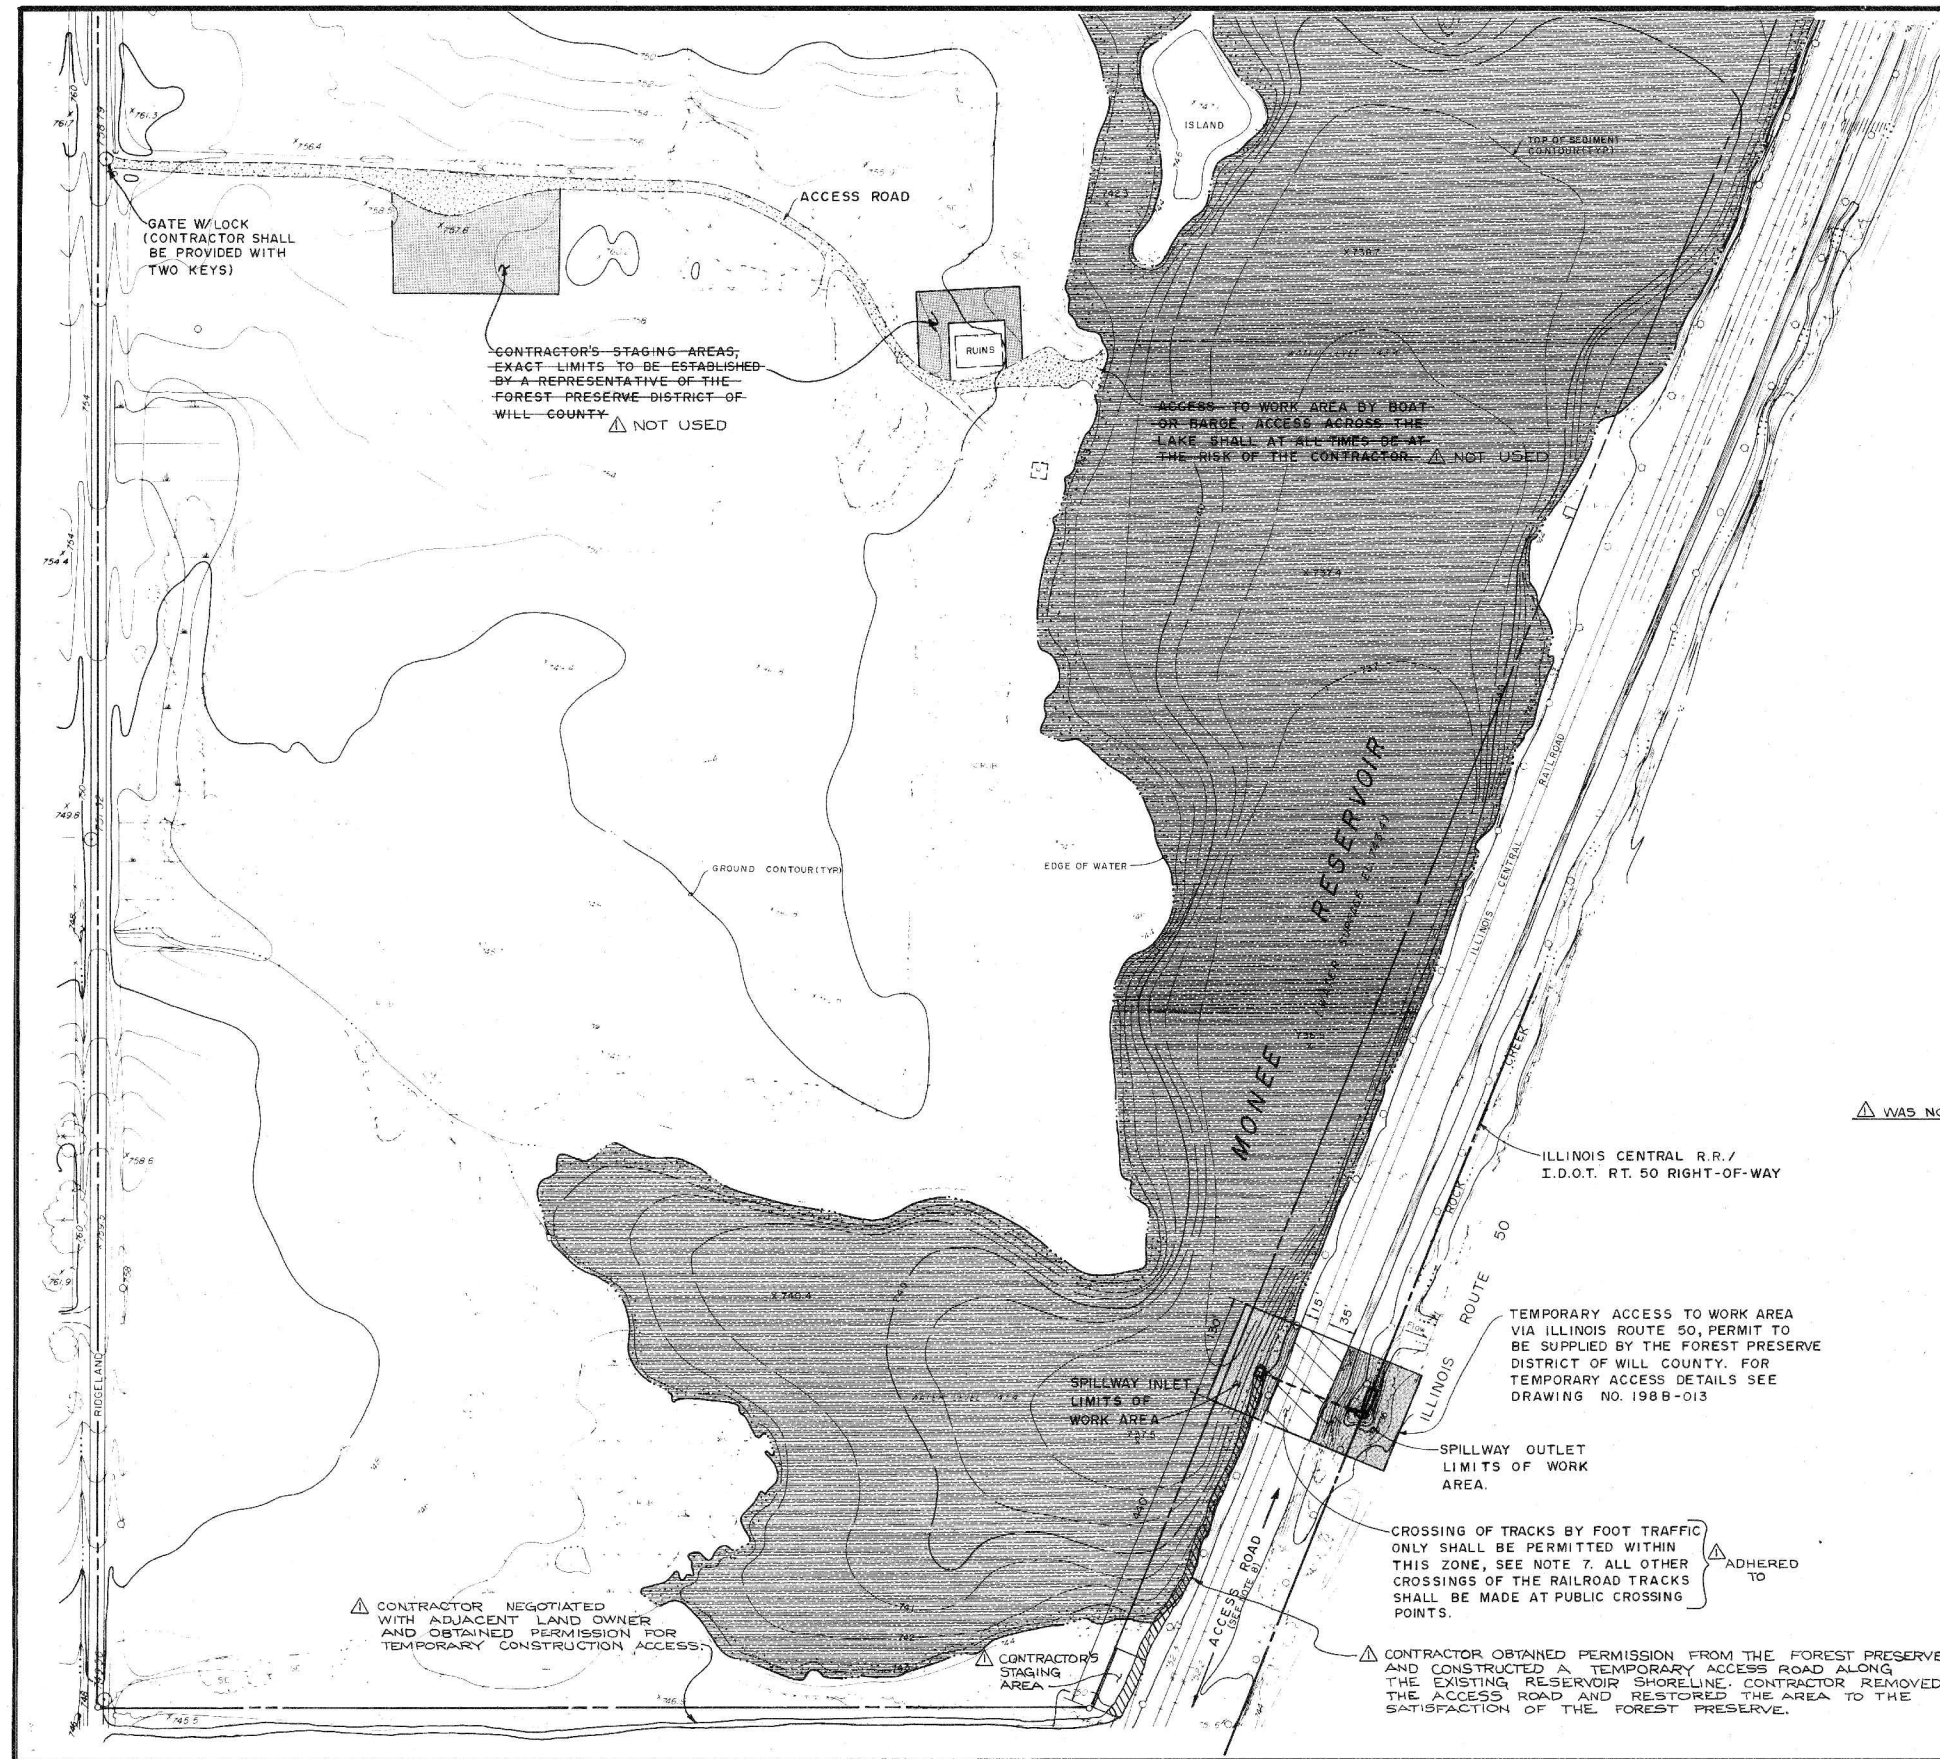

NOTES:

1. FIELD SURVEY OF LAKE BOTTOM TOPOGRAPHY WAS PERFORMED BY PATRICK ENGINEERING INC. IN NOVEMBER 1988 BY TAKING DEPTH PROBES AT MAXIMUM 200 FOOT INTERVALS FROM A ROW BOAT. ELECTRONIC DISTANCE MEASURING EQUIPMENT (EDM TOTAL STATION) WAS USED FOR HORIZONTAL CONTROL.
2. LAND SURFACE TOPOGRAPHY ABOVE LAKE WATER LEVEL COMPILED BY PHOTOGRAMMETRIC METHODS BY AIR MAPS, INC., ELKHART, INDIANA ON NOVEMBER 21, 1977.
3. BENCHMARK USED IS A CHISELED CROSS ON TOP OF THE HEADWALL WHERE THE HEADWALL ABUTS THE SOUTH WINGWALL FOR A TWIN CONCRETE BOX CULVERT ON ROCK CREEK ON THE UPSTREAM SIDE OF IL ROUTE 50 ACROSS FROM THE RESERVOIR OUTLET STRUCTURE, REPORTED EL. 736.08 N.G.V.D.
4. PROPERTY LINES TAKEN FROM PLAT OF SURVEY BY GEOTECH INC., DATED JULY 7, 1982, REVISED NOVEMBER 29, 1982.
5. NO WORK SHALL BE PERFORMED WITHIN 15 FEET OF THE RAILROAD TRACKS.
6. THE CONTRACTOR IS RESPONSIBLE FOR MAINTENANCE OF THE ACCESS ROADS DURING CONSTRUCTION.
7. A REPRESENTATIVE OF THE ILLINOIS CENTRAL RAILROAD SHALL BE PRESENT AT ALL TIMES DURING CONSTRUCTION. THE RESPONSIBILITY OF THE CONTRACTOR, THE RAILROAD WILL REQUIRE CERTIFICATES OF INSURANCE FROM THE CONTRACTOR.
8. THE ACCESS ROAD SHALL NOT BE USED BY THE CONTRACTOR WITHOUT WRITTEN AUTHORIZATION BY THE ILLINOIS CENTRAL RAILROAD.
9. TRAIN TRAFFIC SHALL NOT BE SLOWED OR DELAYED BY THE CONTRACTOR'S ACTIVITIES.
10. STAGING AREA TO BE RESTORED BY CONTRACTOR TO PRECONSTRUCTION CONDITIONS.

△ WAS NOT PRESENT AT ANY

SCALE 0 100 200 FEET
1" = 100'


2/24/88 "AS BUILT" INFORMATION		RML	JCS
REV.	DATE	DESCRIPTION	DR BY APP BY
SCALE:	AS SHOWN	PROJECT:	
DATE:	MAY, 1988	MONEE RESERVOIR OUTLET STRUCTURE IMPROVEMENTS	
DES BY:	JCS	SHEET TITLE:	
DR BY:	HB	ACCESS ROAD AND CONTRACTOR STAGING AREAS	
CHK BY:	JCS		
APP BY:	DPD		
PATRICK ENGINEERING INC. Geotechnical/Environmental Engineers Glen Ellyn, Illinois		SHEET _____ OF _____ DRAWING NO. 198D-011	

JUN 22, 2013 1:41 PM SCH000827






DATE	SOURCE




SSA MASTER PLAN - FLOODPLAINS REPORT
APPENDIX D-4 (CONT.)
AS BUILT/ RECORD DRAWINGS FOR MONEE RESERVOIR

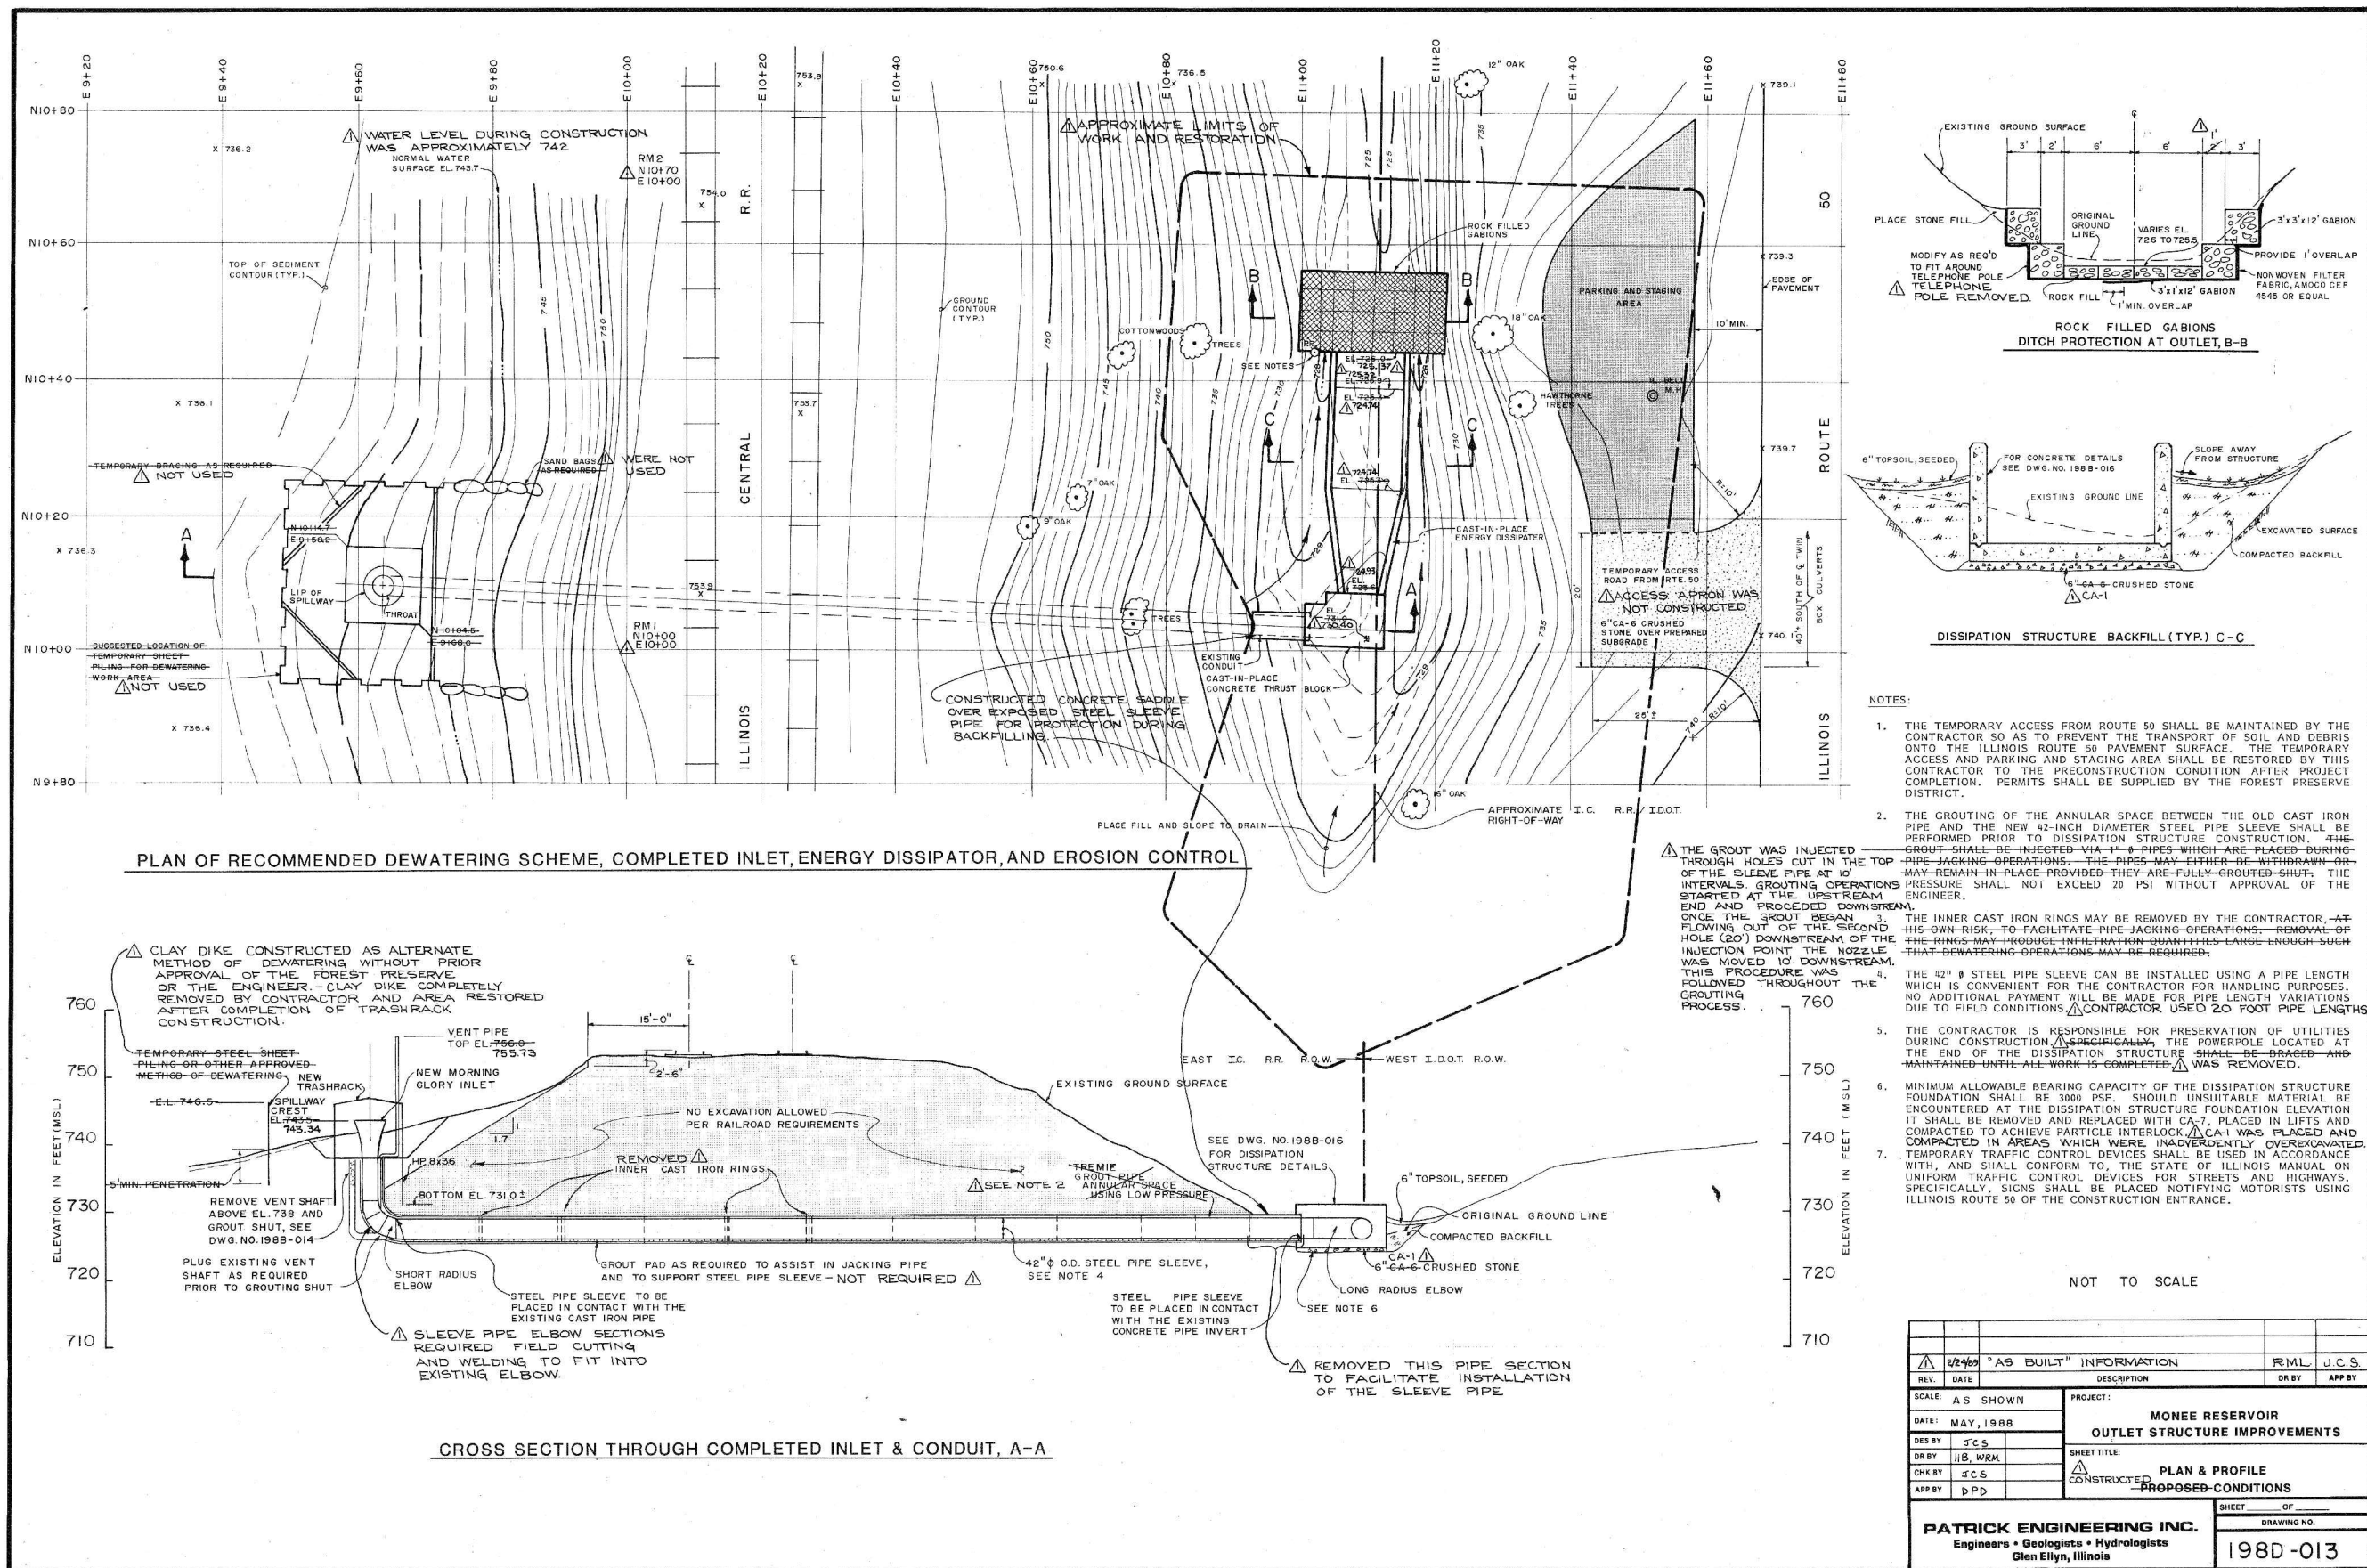

DATE	SOURCE

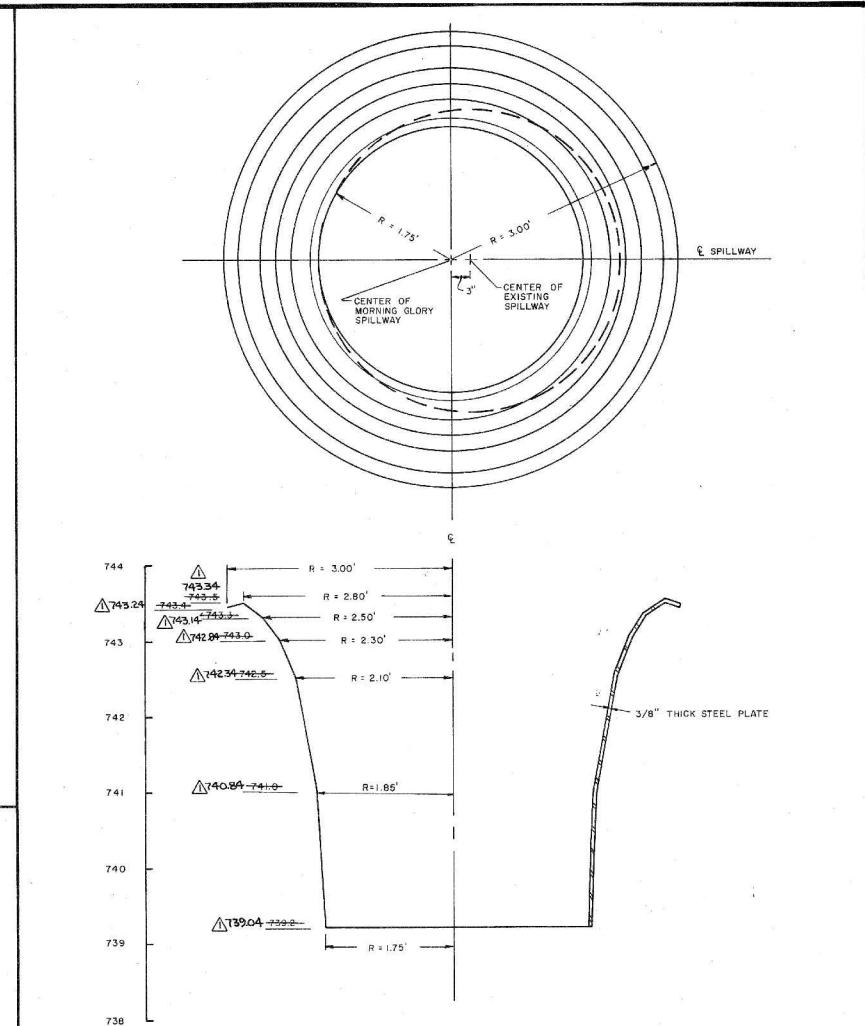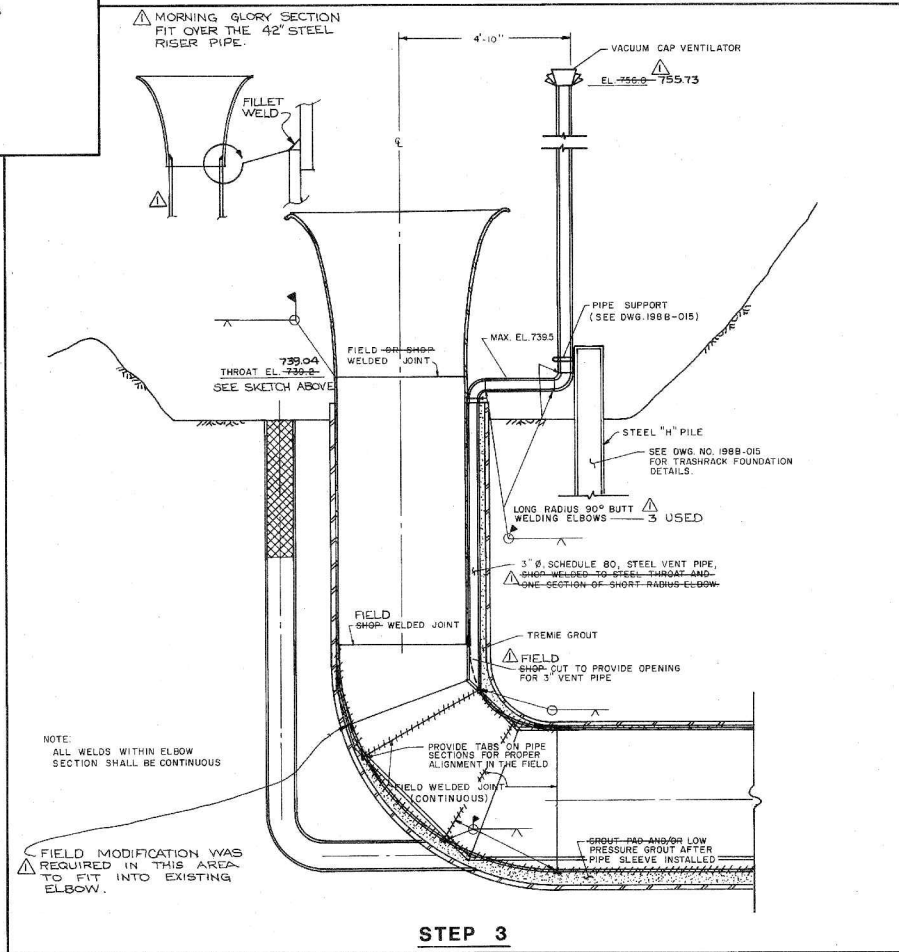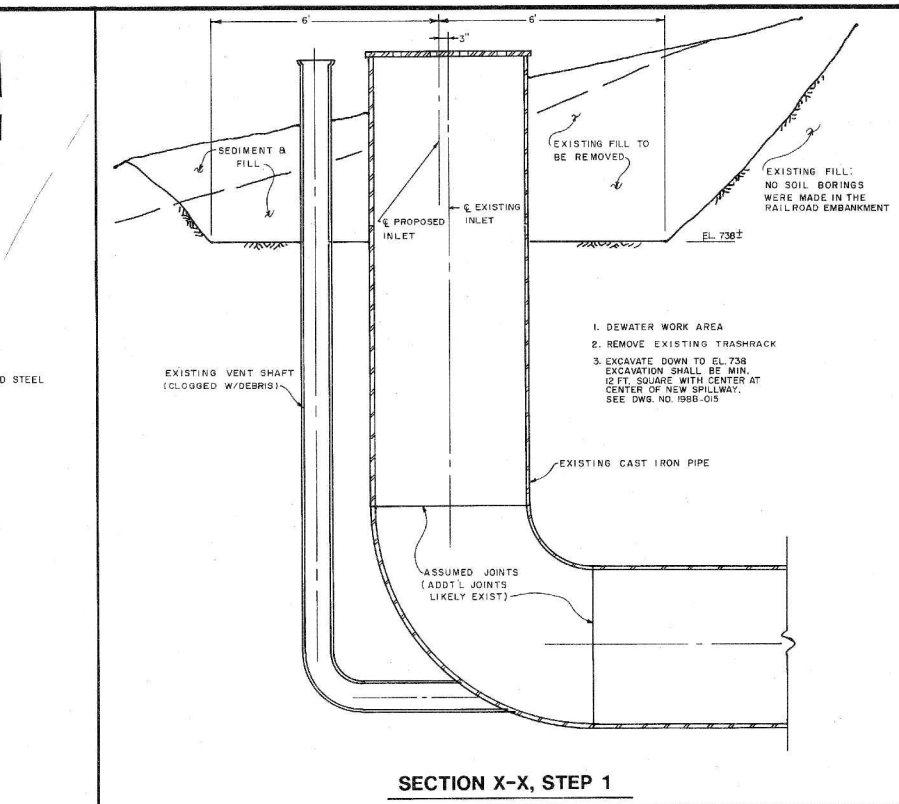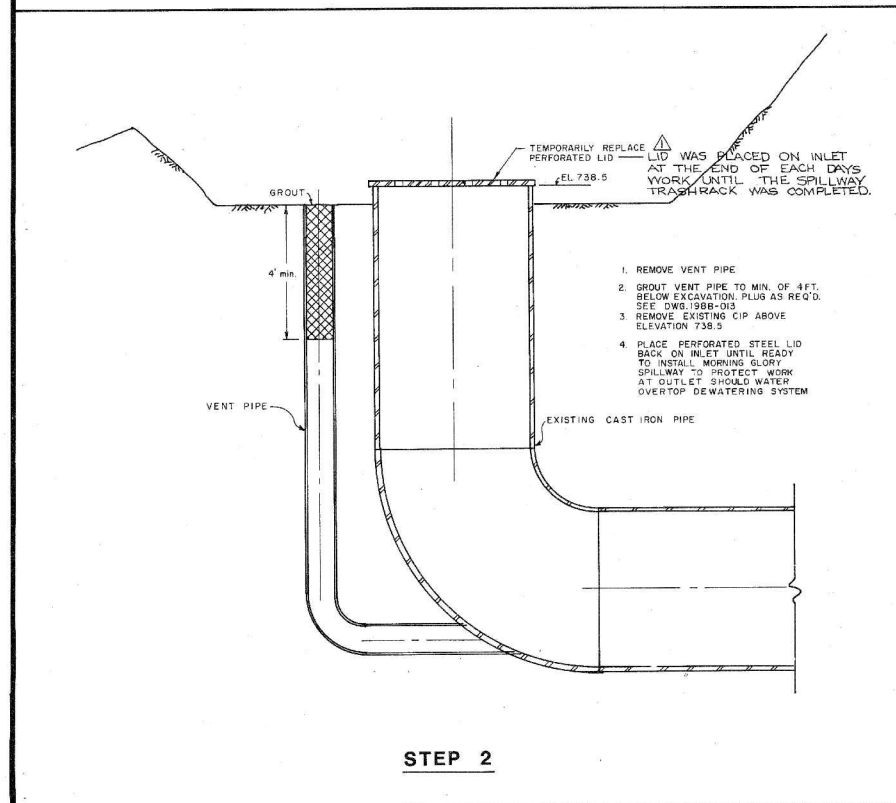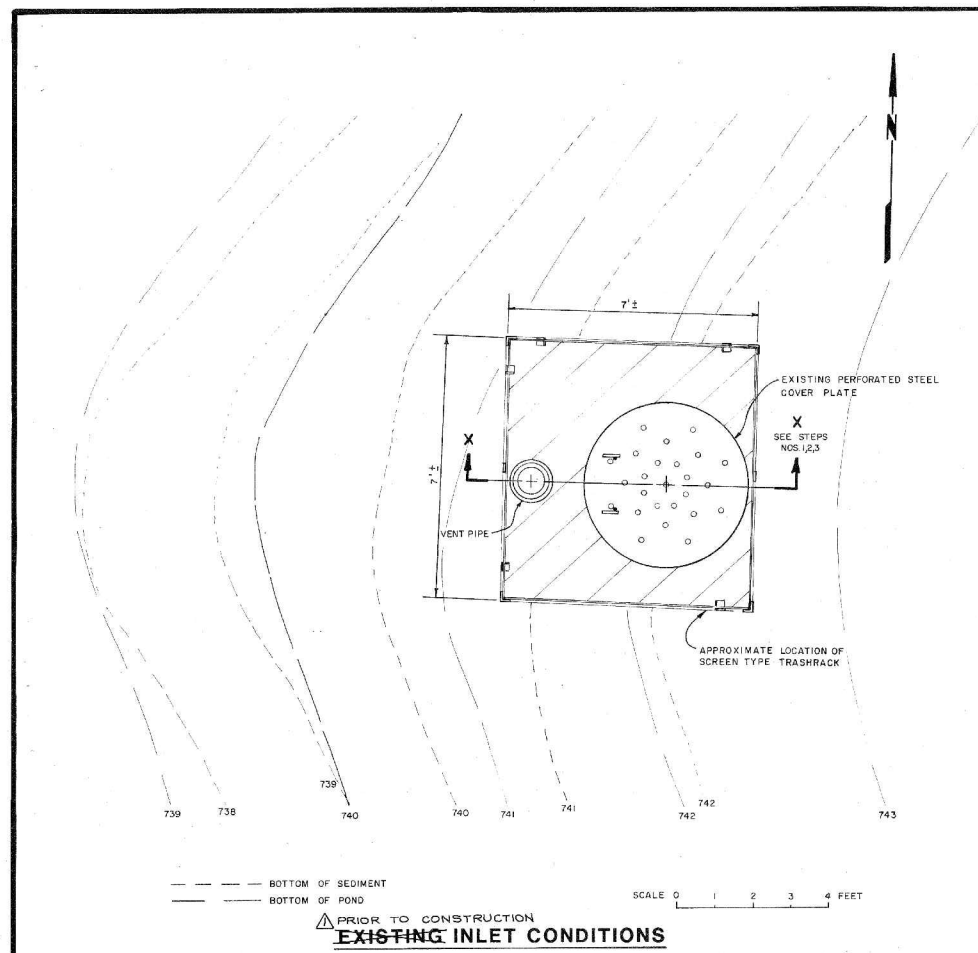

(TO BE SHOP FABRICATED AND APPROVED BY ENGINEER PRIOR TO SHIPPING TO JOB SITE)

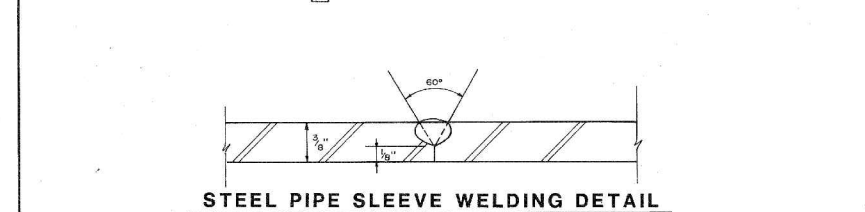


- NOTES:**
1. THE PLAN SHOWN FOR STAGING OF INLET CONSTRUCTION IS ONLY A RECOMMENDATION. THE CONTRACTOR IS SOLELY RESPONSIBLE FOR THE METHODS, PROCEDURES, AND RESULTS OF SAME IN ACCOMPLISHING THE WORK.
 2. THE WORK SHALL BE PERFORMED IN DRY CONDITIONS AND THE RESERVOIR WATER LEVEL SHALL BE MAINTAINED BY THE CONTRACTOR BETWEEN EL. 746 AND 749.5 USING A SERIES OF PUMPS AND FORCE MAINS.


WATER LEVEL DURING CONSTRUCTION WAS APPROXIMATELY 742.0 DUE TO VERY DRY SUMMER

REV.	DATE	DESCRIPTION	DR BY	APP BY
2/04/89		"AS BUILT" INFORMATION	R.M.L.	J.C.S.
SCALE:	AS SHOWN	PROJECT:	MONEE RESERVOIR	
DATE:	MAY, 1988	SHEET TITLE:	OUTLET STRUCTURE IMPROVEMENTS	
DES BY:	JCS			
DR BY:	WAR			
CHK BY:	JCS			
APP BY:	DPD			
PATRICK ENGINEERING INC.			SHEET 1 OF 1	
Engineers • Geologists • Hydrologists			DRAWING NO.	
Glen Ellyn, Illinois			198D-014	


DATE	SOURCE

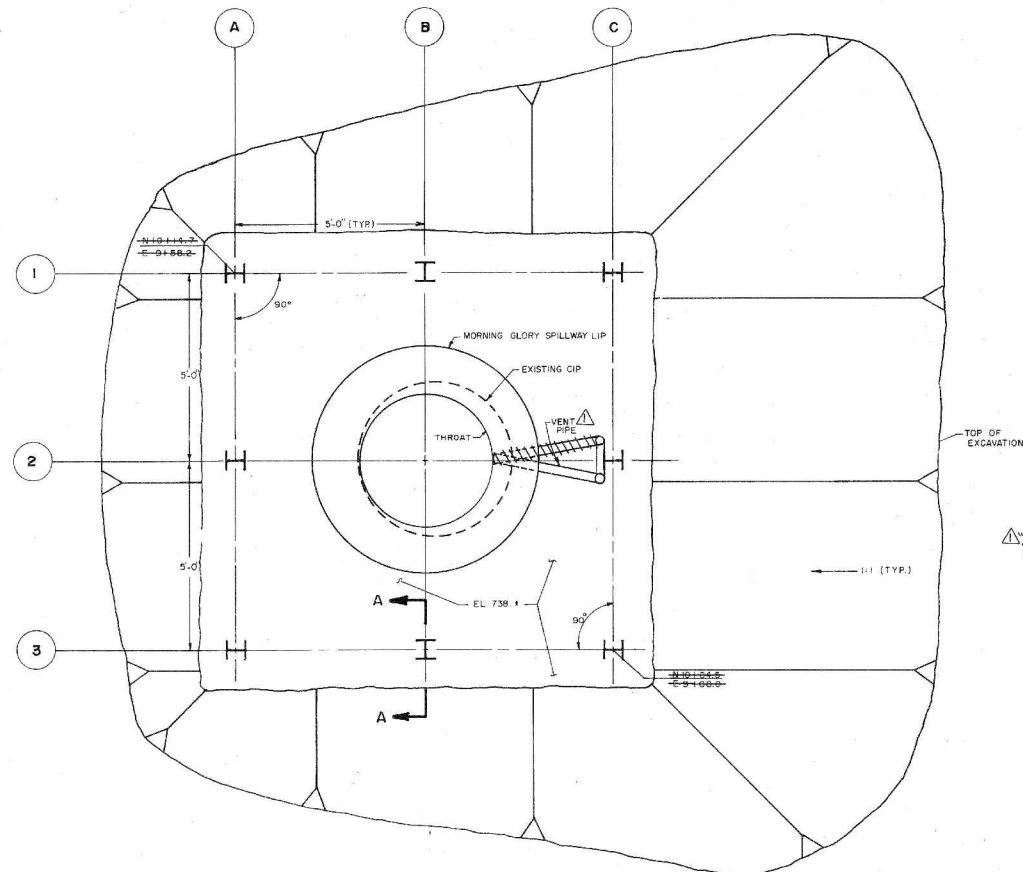


TRASHRACK FOUNDATION PLAN

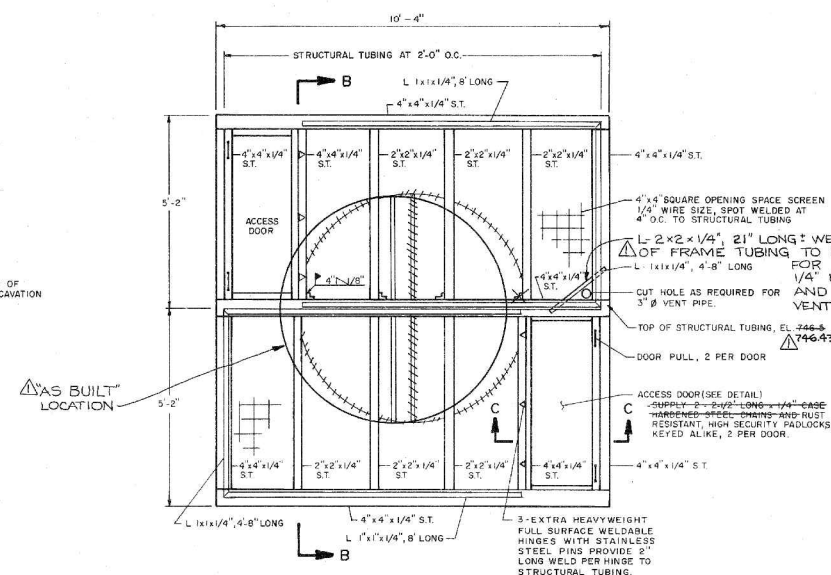


STRUCTURAL PLAN OF TRASHRACK

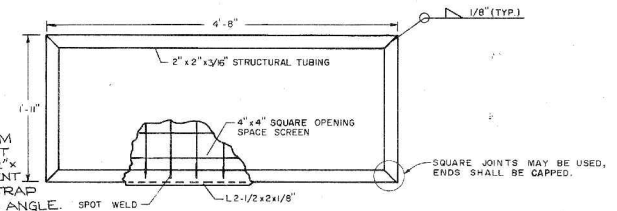


ACCESS DOOR FRAME - PLAN

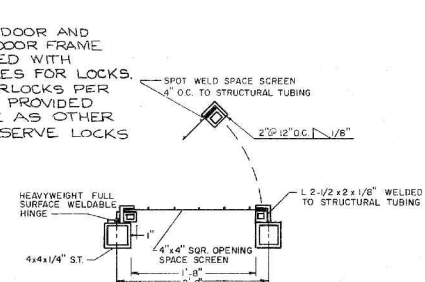


ACCESS DOOR DETAIL, C-C

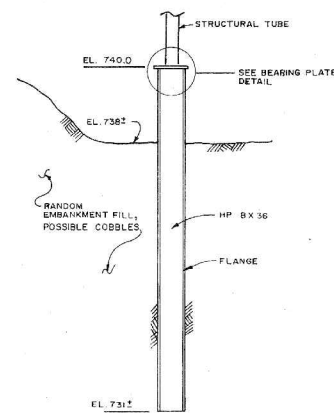


PILE FOUNDATION, A-A

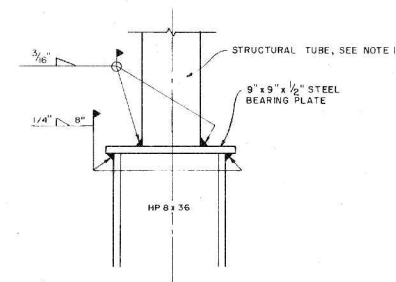

BEARING PLATE DETAIL

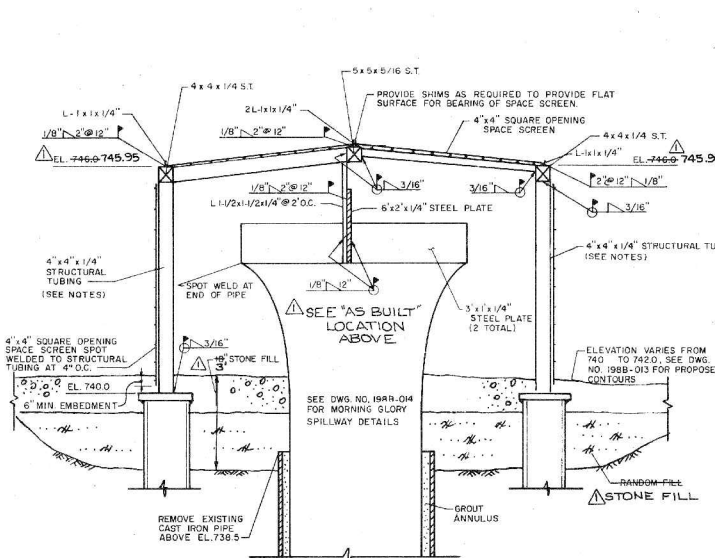

TRASHRACK CROSS-SECTION, B-B

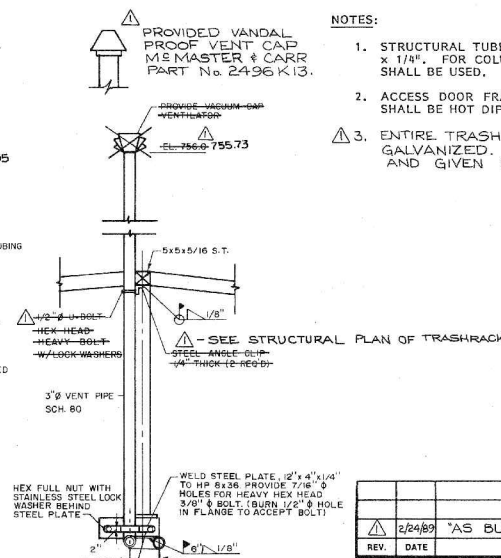


VENT PIPE MOUNTING DETAIL

NOTES:

1. STRUCTURAL TUBES FOR COLUMN LINES A AND C SHALL BE 4" X 4" X 1/4". FOR COLUMN LINE B, 5" X 5" X 1/16" STRUCTURAL TUBES SHALL BE USED.
2. ACCESS DOOR FRAMES SHALL BE FABRICATED IN THE SHOP AND SHALL BE HOT DIP GALVANIZED AFTER FABRICATION.
3. ENTIRE TRASHRACK STRUCTURE IS HOT DIP GALVANIZED. FIELD WELDS WERE CLEANED AND GIVEN 2 COATS OF ZINC OXIDE PAINT.

REV.	DATE	DESCRIPTION	DR BY	APP BY
1	2/24/89	"AS BUILT" INFORMATION	R.M.L.	J.C.S.
SCALE: NOT TO SCALE				
DATE: MAY, 1988				
DES BY	JCS	RLG	PROJECT: MONEE RESERVOIR OUTLET STRUCTURE IMPROVEMENTS	
DR BY	WAR			
CHK BY	JCS			
APP BY	DPD			
PATRICK ENGINEERING INC. Engineers • Geologists • Hydrologists Glen Ellyn, Illinois				SHEET _____ OF _____ DRAWING NO. 198D-015

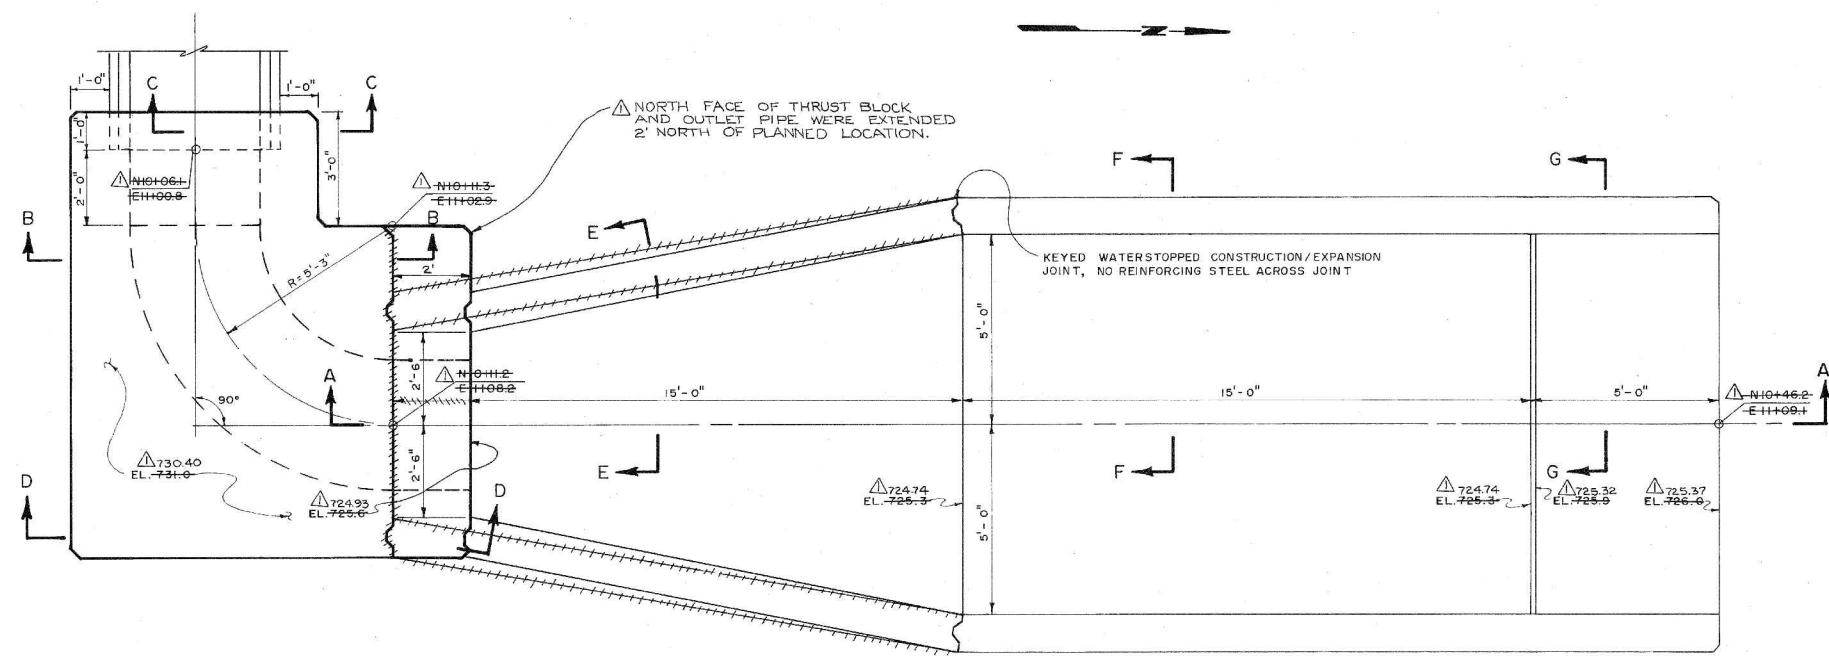

PLAN OF THRUST BLOCK AND DISSIPATION STRUCTURE

DISSIPATION STRUCTURE REINFORCEMENT STEEL SCHEDULE			DIMENSIONS (FEET-INCHES)				
MARK	QUANTITY	LENGTH FEET-INCHES	A	B	C	D	E
B ₁	30	4'-3"	1'-9"	2'-5"	1'-9"	2'-6"	2'-6"
B ₂	15	15'-9"	3'-4"	4'-5"	1'-9"	3'-4"	3'-4"
B ₃	11	7'-10"					
B ₄	5	20'-5"					
V ₁	60	6'-0"					
V ₂	38	1'-3"					
V ₃	38	1'-9"					
V ₄	60	5'-3"					
V ₅	16	5'-3"					
V ₆	10	4'-9"					
V ₇	2	4'-9"					
H ₁	30	11'-3"					
H ₂	6	8'-3"					
H ₃	4	5'-6"					
H ₄	13	3'-6"					
H ₅	21	8'-0"					
H ₆	12	1'-6"					
H ₇	8	4'-0"					
H ₈	16	1'-6"					
H ₉	8	2'-6"					
H ₁₀	4	3'-6"					
H ₁₁	4	4'-0"					
H ₁₂	4	6'-0"					
H ₁₃	10	1'-0"					
H ₁₄	12	10'-0"					
H ₁₅	8	2'-0"					
H ₁₆	8	3'-0"					
H ₁₇	4	4'-0"					
H ₁₈	3	6'-0"					
H ₁₉	3	6'-10"					
H ₂₀	10	8'-6"					
H ₂₁	10	10'-2"					
H ₂₂	10	19'-9"					
H ₂₃	10	14'-5"					
H ₂₄	14	14'-6"					
H ₂₅	4	9'-6"					
H ₂₆	4	4'-6"					
H ₂₇	20	10'-2"					
H ₂₈	22	19'-9"					
H ₂₉	10	14'-5"					
H ₃₀	10	19'-6"					
H ₃₁	6	14'-6"					
H ₃₂	5	19'-6"					

BAR TYPES

O.C. - ON CENTER

E.W. - EACH WAY


E.F. - EACH FACE

CL. - CLEARANCE

GTR. - CENTER

*FIELD CUT AS REQUIRED


STANDARD ABREVIATIONS

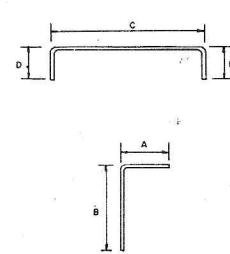


BAR TYPES

O.C. - ON CENTER
E.W. - EACH WAY
E.F. - EACH FACE
C.L. - CLEARANCE
CTR. - CENTER


STANDARD ABBREVIATIONS

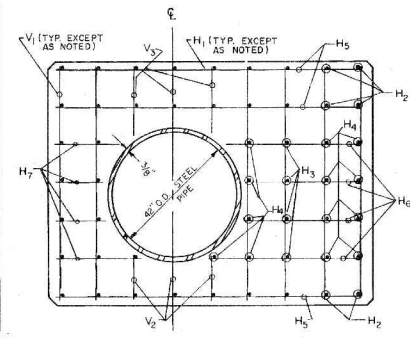


THRUST BLOCK REINFORCING DETAIL, B-B

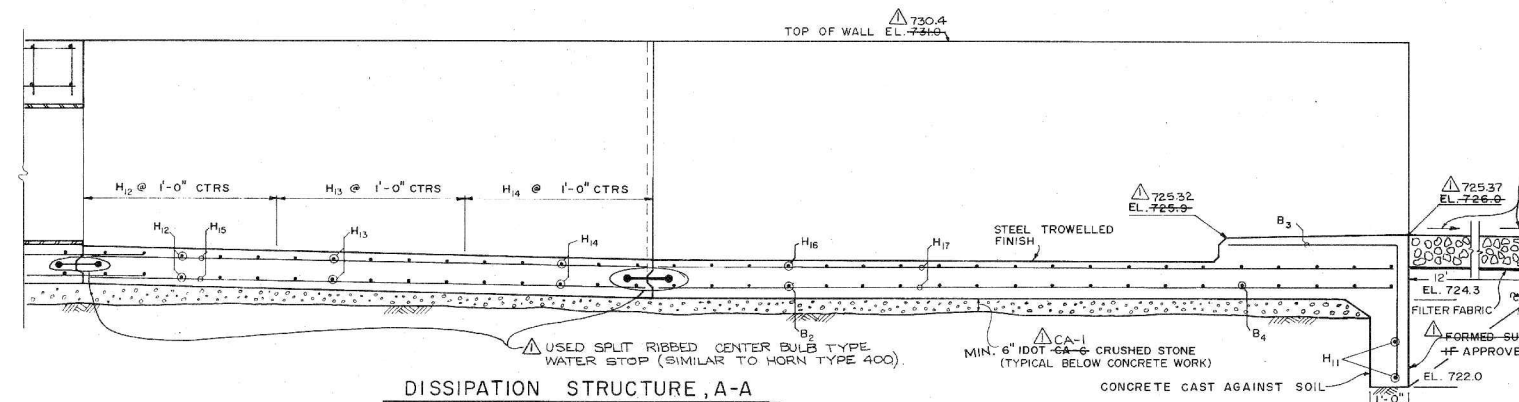


DISSIPATION STRUCTURE, A-A

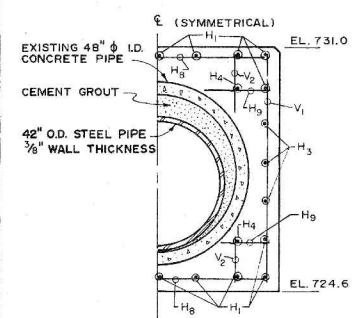


CONNECTION TO EXISTING OUTLET PIPE, C-C

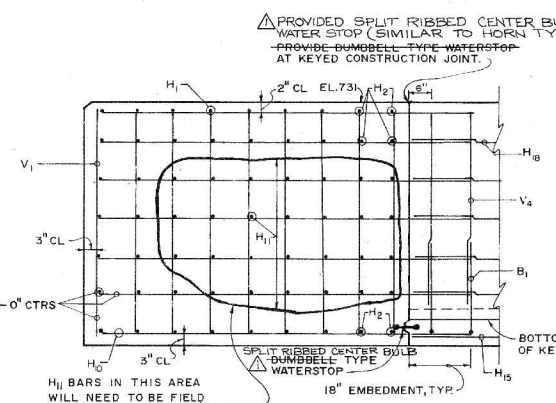


THRUST BLOCK REINFORCING DETAIL, D-D

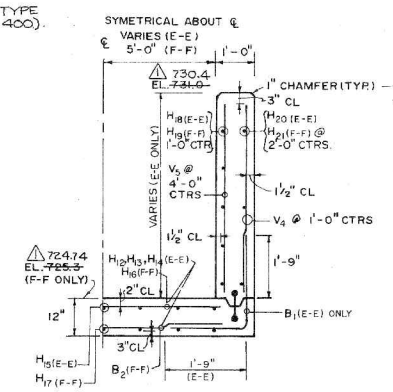


TRANSITION WALL DETAIL, E-E
STILLING BASIN WALL DETAIL, F-F

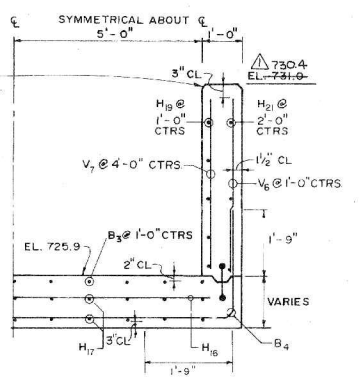

END SILL WALL DETAIL, G-G

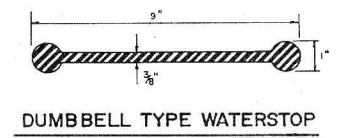

DUMBBELL TYPE WATERSTOP

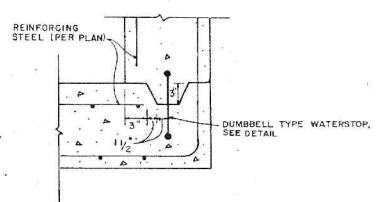

CONSTRUCTION JOINT DETAIL

- NOTES:
1. ALL REINFORCING STEEL SHALL BE GRADE 60, #4 DEFORMED BARS. ALL BARS EXTENDING THROUGH COLD JOINTS AND CONSTRUCTION JOINTS SHALL BE EPOXY COATED IN ACCORDANCE WITH IDOT SPECIFICATIONS.
 2. CONCRETE SHALL HAVE A MINIMUM COMPRESSIVE STRENGTH OF 3500 PSI AT AN AGE OF 28 DAYS.
 3. ALL EXPOSED CONCRETE EDGES SHALL HAVE A 1-INCH CHAMFER.

28465 "AS BUILT" INFORMATION		R.M.L.	J.C.S.
REV.	DATE	DESCRIPTION	DR BY
SCALE: NOT TO SCALE		PROJECT: MONEE RESERVOIR	
DATE: MAY, 1988		OUTLET STRUCTURE IMPROVEMENTS	
DES BY: J.C.S.	DR BY: BAF/WAR	SHEET TITLE: DISSIPATION STRUCTURE DETAILS	
CHK BY: J.C.S.	APP BY: D.P.D.	PATRICK ENGINEERING INC. Engineers • Geologists • Hydrologists Glen Ellyn, Illinois	
SHEET 1 OF 1		DRAWING NO. 198D -016	

JUN 22, 2013 1:47 PM SCH000827

DATE	SOURCE



SSA MASTER PLAN - FLOODPLAINS REPORT
APPENDIX D-4 (CONT.)
AS BUILT/ RECORD DRAWINGS FOR MONEE RESERVOIR